IREDELL COUNTY HEALTH DEPARTMENT

STATESVILLE 704-878-5305 MOORESVILLE 704-664-5281

IMPROVEMENT PERMIT / AUTHORIZATION TO CONSTRUCT / OPERATION PERMIT / EXISTING SYSTEM INSPECTION

PERMIT# 71574 PIN# 4723704601 DATE 2-2-98

OWNER OR CONTRACTOR Chris Davidson PHONE: Business 704 528 6192 Home

ADDRESS PO Box 5602 Statesville, N.C.

LOCATION Buffalo Shoals Turn on Davidson Rt on Buffaloway 4th lot left

SUBDIVISION 123 Buffaloway BLOCK / SECTION LOT 7 LOT AREA 3/4 acre SITE CLASS. P3 DESIGN FLOW 360 L.T.A.R. .3

Septic Tank: 1000 Gallons; STB 1012 Date 5-4-94

Pump Tank: Gallons; PT Date

Pump Make: Model Serial No.

Nitrification Field: No Fields 1 Square Feet 1200 Linear Feet 400

No Lines 3 Trench Width 36" Max Trench Bottom Depth 36" Gravel Depth 12"

☑ New System ☐ Repair System Type: I ☐ II ☐ III, IV, V, VI

System Description: Conv. Gravity

Repair System Description: Gravity chambers

Maintenance Agreement Required: ☐ Yes ☑ No

☑ House/Mod. Home No. Bedrooms 3

☐ Mobile Home No. Bathrooms 2

☐ Business No. Employees

☐ Other


☐ Slab ☑ Crawl Space ☐ Basement w/plumbing ☐ Basement wo/plumbing

Water Supply: ☑ Individual ☐ Public ☐ Community

Comments:/Conditions: Keep System 100' from any well

Comments:/Conditions: * Note: Lines length Charged to 100 ft

INITIAL SITE SKETCH

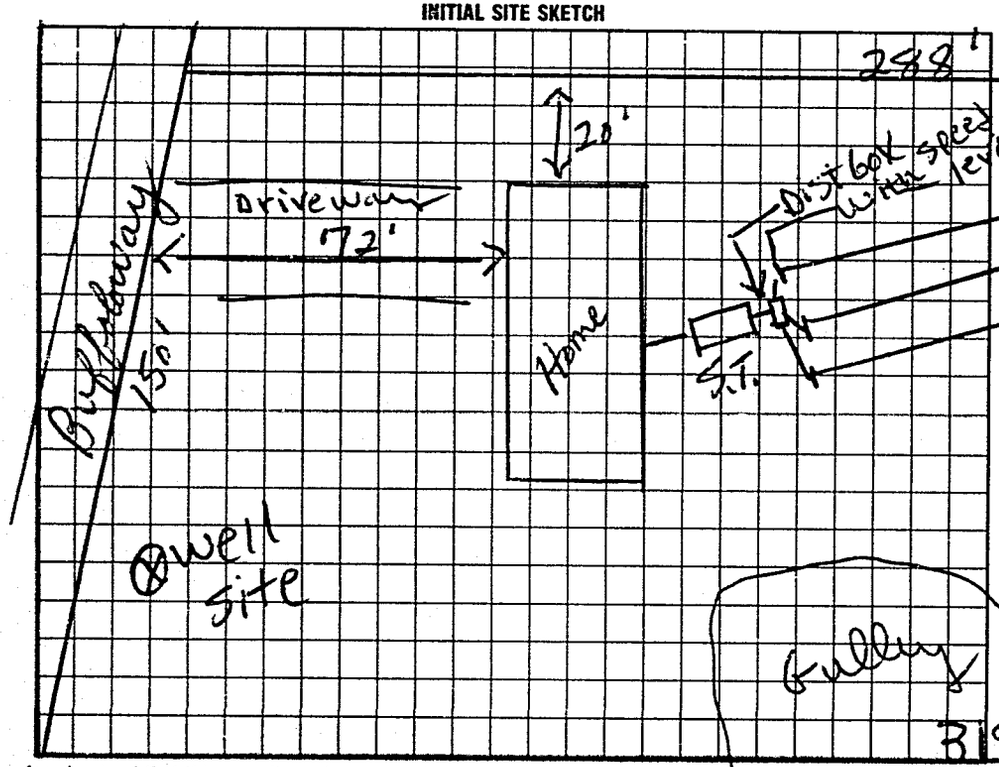

AS BUILT SKETCH

I understand that this permit can be suspended or revoked if any false information is supplied toward securing the permit/any unauthorized changes are made to the site/any unauthorized changes are made in the installation of the system. Improvement Permit with plat valid without expiration. Improvement Permit with site plan valid for sixty months. Authorization to Construct is valid for a period equal to that of Improvement Permit – not to exceed sixty months.

Signed: Neal Kall date

Improvement Permit by: E.C. moore date 2-2-98

Authorization to Construct by: E.C. moore date 2-2-98

Installed by: David Yountz

Operation Permit by: Not Required date 8-3-98

Existing System Inspection by: date

HEALTH DEPT COPY WHITE INSPECTION COPY (FINAL) GREEN OWNER COPY (FINAL) YELLOW INSPECTION COPY (INITIAL) PINK OWNER COPY (INITIAL) GOLD

S 2 0 1 0 0