IREDELL COUNTY HEALTH DEPARTMENT

STATESVILLE 704-878-5305 MOORESVILLE 704-664-5281

#130

IMPROVEMENT PERMIT / AUTHORIZATION TO CONSTRUCT / OPERATION PERMIT / EXISTING SYSTEM INSPECTION

PERMIT# 119943 PIN# 4723-70-4361 DATE March 22, 04

OWNER OR CONTRACTOR Spear Bld. Inc. PHONE: Business _____ Home _____

ADDRESS 192 Wildwood Cove Dr, Mooresville, N.C. 28117

LOCATION From Trautman Old Mtn. Rd. TR Buffalo Shoals TR Davidson Rd. TR Winding Cedar on Right

SUBDIVISION Davidson Woods BLOCK / SECTION 1 LOT 7/7A LOT AREA .56Ac + .25AcSFE SITE CLASS PS SFE 5-7A DESIGN FLOW 360gpd L.T.A.R. n.3

Septic Tank: 1000 Gallons; STB 825 Date 3-20-04
Pump Tank: 1000 Gallons; PT 302 Date 3-7-04
Pump Make: Zoeller Model N-140 C Serial No. 140-0602
Nitrification Field: No Fields 1 Square Feet 900 Linear Feet 300
No Lines 3 @ 100' Trench Width 36" Max Trench Bottom Depth 36" Gravel Depth N/A


☑ New System ☐ Repair System Type: I, II, III, IV, V, VI
System Description: PM - 25% Reduction
Repair System Description: LPPBPS
Maintenance Agreement Required: ☐ Yes ☑ No, initially

☑ House/Mod. Home No. Bedrooms 3
☐ Mobile Home No. Bathrooms 2
☐ Business No. Employees ____
☐ Other ____
☐ Slab ☑ Crawl Space ☐ Basement w/plumbing ☐ Basement wo/plumbing

Water Supply: ☐ Individual ☑ Public ☑ Community


Comments:/Conditions:
Install small berm along this pl. to divert stormwater/gutter downspout from lot 4 around SFE 5-7A

INITIAL SITE SKETCH 1"=50'

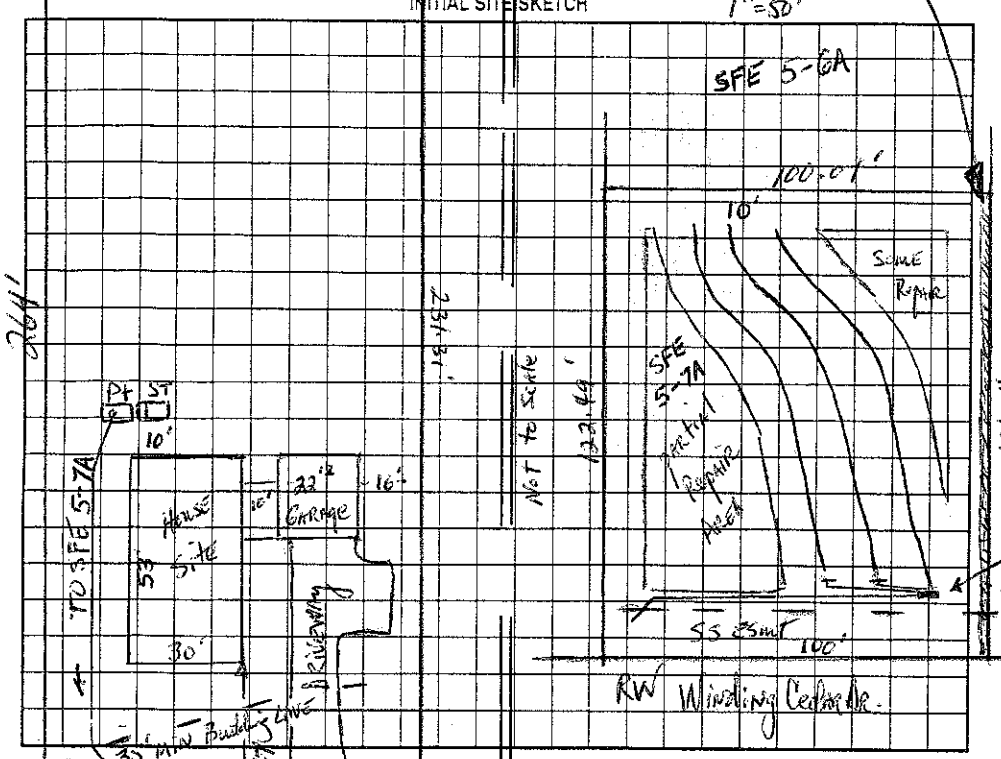

Comments:/Conditions:
DIG'D TO MOVE TANKS VID LEVELS TANKS & PRESSURE LC: 5-19-04
POLYLOK FILTER & MARKER
NEEDS ELECTRICAL & SURFACE SWELL
Okay 5/24/04

AS BUILT SKETCH

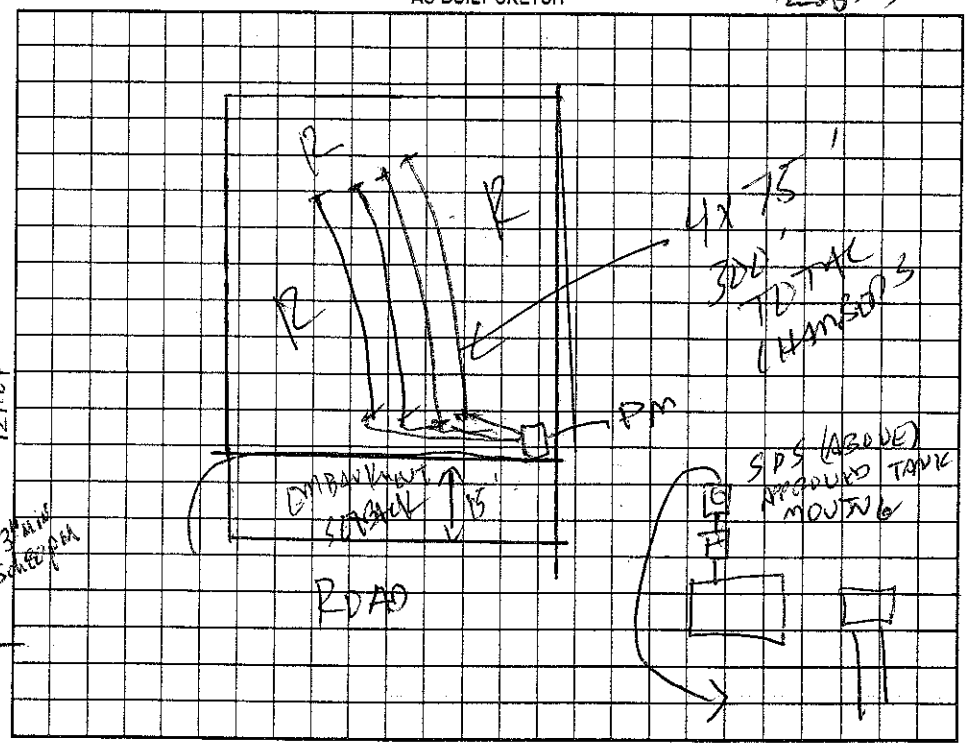

Permit can be suspended or revoked if any false information is supplied toward securing the permit/any unauthorized changes are made to the site/any unauthorized changes are made in the installation of the system. Improvement Permit with plat valid without expiration. Improvement Permit with site plan valid for sixty months. Authorization to Construct is valid for a period equal to that of Improvement Permit – not to exceed sixty months.

Signed: _____ date 3-22-04 Installed by: ROWAN SEPTIC

Improvement Permit By: _____ date 3-22-04 Operation Permit by: _____ date 5/24/04

Authorization to Construct by: _____ date 3-22-04 Existing System Inspection by: _____ date _____

HEALTH DEPT. COPY: WHITE OWNER COPY (FINAL): YELLOW OWNER COPY (INITIAL): PINK