IREDELL COUNTY HEALTH DEPARTMENT

STATESVILLE 704-878-5305 130.00 Paid MOORESVILLE 704-664-5281

IMPROVEMENT PERMIT / AUTHORIZATION TO CONSTRUCT / OPERATION PERMIT / EXISTING SYSTEM INSPECTION

PERMIT# 111566 PIN# 4723-70-4185.2 4723-70-7771 DATE Aug 13, 03

OWNER OR CONTRACTOR Mountain Creek Investments - Spotte Court PHONE: Business Home

ADDRESS 117 Whaling Dr. Mooresville, N.C. 28117

LOCATION From Troutman Old Mtn Rd. TR Buffalo Shoals Rd. TR Davidson Rd TR Winding Cedar 2nd lot on Right

SUBDIVISION Davidson Woods BLOCK / SECTION 1 LOT 2 LOT AREA .47Ac SITE CLASS. 5 DESIGN FLOW 360gpd L.T.A.R. .25-.3

Septic Tank: 1000 Gallons; STB 825 Date 9-8-03
Pump Tank: 1000 Gallons; PT 302 Date 11-15-03
Pump Make: Zoeller Model N-98-B Serial No. —
Nitrification Field: No Fields 1 Square Feet 1080 Linear Feet 360
No Lines 4@90' Trench Width 36" Max Trench Bottom Depth 36" Gravel Depth NA

☑ New System ☐ Repair System Type: I, II, III, IV, V, VI
System Description: pm - 25% Reduction
Repair System Description: LPP825
Maintenance Agreement Required: ☐ Yes ☑ No initially

☑ House/Mod. Home No. Bedrooms 3
☐ Mobile Home No. Bathrooms 2
☐ Business No. Employees
☐ Other


☐ Slab ☑ Crawl Space ☐ Basement w/plumbing ☐ Basement wo/plumbing

Water Supply: ☐ Individual ☐ Public ☑ Community


Comments:/Conditions:

Comments:/Conditions: - 58 Infiltrator Chambers Installed
- Poly Lok filter Installed
- Lines + Pressure Check Okay WJH (10/22/03)

1"=50' INITIAL SITE SKETCH

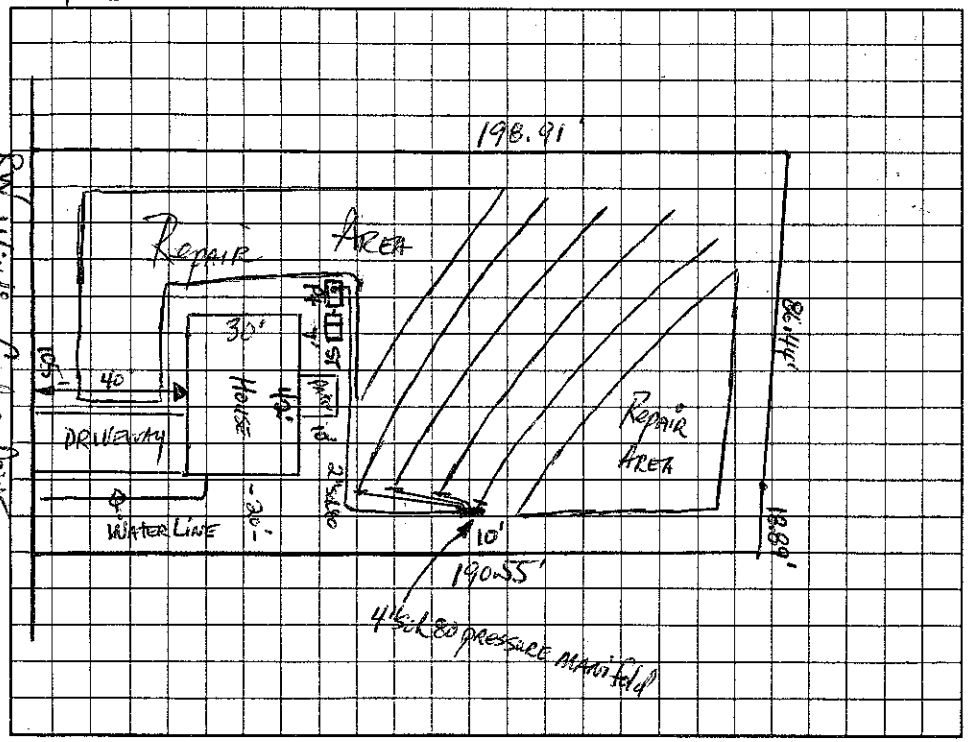

AS BUILT SKETCH (Not to Scale)

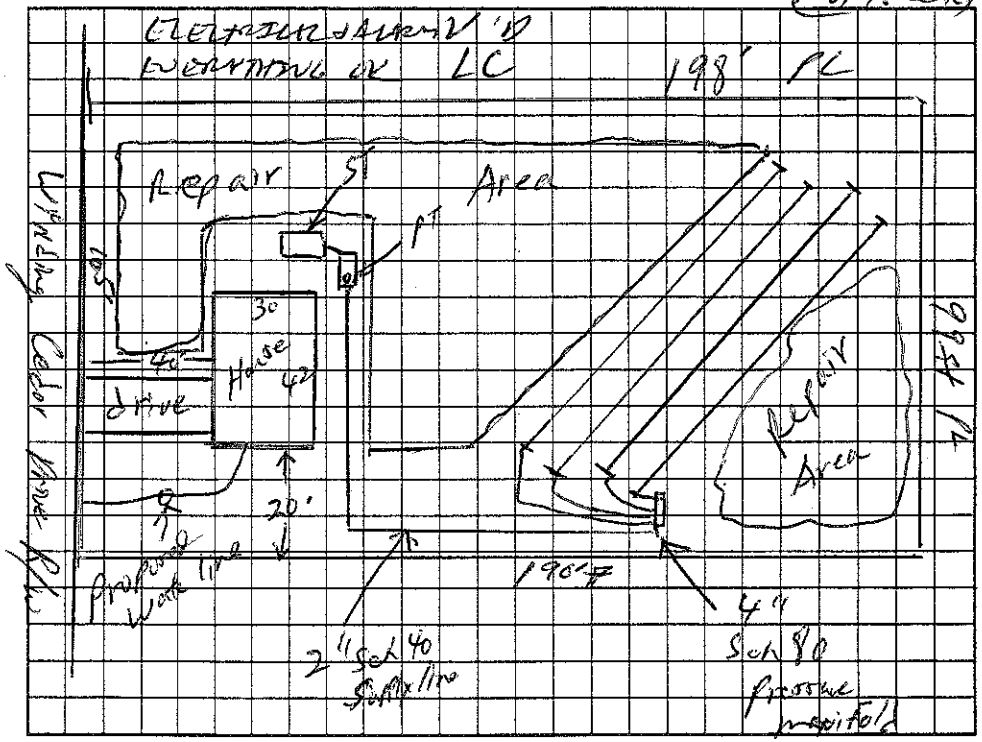

Permit can be suspended or revoked if any false information is supplied toward securing the permit/any unauthorized changes are made to the site/any unauthorized changes are made in the installation of the system. Improvement Permit with plat valid without expiration. Improvement Permit with site plan valid for sixty months. Authorization to Construct is valid for a period equal to that of Improvement Permit – not to exceed sixty months.

Signed: date 8/14/03 Installed by: Rowan Septic (10/22/03)

Improvement Permit by: date 8-13-03 Operation Permit by: date 11-16-03

Authorization to Construct by: date 8-13-03 Existing System Inspection by: date

HEALTH DEPT. COPY: WHITE OWNER COPY (FINAL): YELLOW OWNER COPY (INITIAL): PINK