IREDELL COUNTY HEALTH DEPARTMENT

STATESVILLE 704-878-5305 (CI) / 130.00 Paid MOORESVILLE 704-664-5281

IMPROVEMENT PERMIT / AUTHORIZATION TO CONSTRUCT / OPERATION PERMIT / EXISTING SYSTEM INSPECTION

PERMIT# 111583 PIN# 4723-70-4483.14 (617) DATE Feb. 20, 2004

OWNER OR CONTRACTOR Mountain Creek Investment PHONE: Business _____ Home _____

ADDRESS 117 Whirling Dr. Mooresville N.C. 28117

LOCATION From Troutman 115-21 N to old Mtn. Rd. TR Buffalo Shoals TR Davidson Rd TR Winding Cedar Lot on left before creek; SFE 1st on R

SUBDIVISION Davidson Woods BLOCK / SECTION _____ LOT 14/14A LOT AREA .47Ac + .25Ac SFE SITE CLASS. PS DESIGN FLOW 360gpd L.T.A.R. .25-.3 SFE 1-14A


Septic Tank: 1000 Gallons; STB 835 Date 4-30-04
Pump Tank: 1000 Gallons; PT 302 Date 4-17-04
Pump Make: ZOELLER Model N-165 Serial No. _____
Nitrification Field: No Fields 1 Square Feet 1080 Linear Feet 360
No Lines 4 @ 90' Trench Width 36" Max Trench Bottom Depth 36" Gravel Depth NA

☑ New System ☐ Repair System Type: I, II, III, IV, V, VI
System Description: Rm - 25% Reduction on SFE 1-14A
Repair System Description: LPPPBPS on SFE 1-14A
Maintenance Agreement Required: ☐ Yes ☑ No Initially

☑ House/Mod. Home No. Bedrooms 3
☐ Mobile Home No. Bathrooms 2
☐ Business No. Employees _____
☐ Other _____
☐ Slab ☑ Crawl Space ☐ Basement w/plumbing ☐ Basement wo/plumbing


Water Supply: ☐ Individual ☑ Public ☑ Community

Comments:/Conditions: 1" = 50'

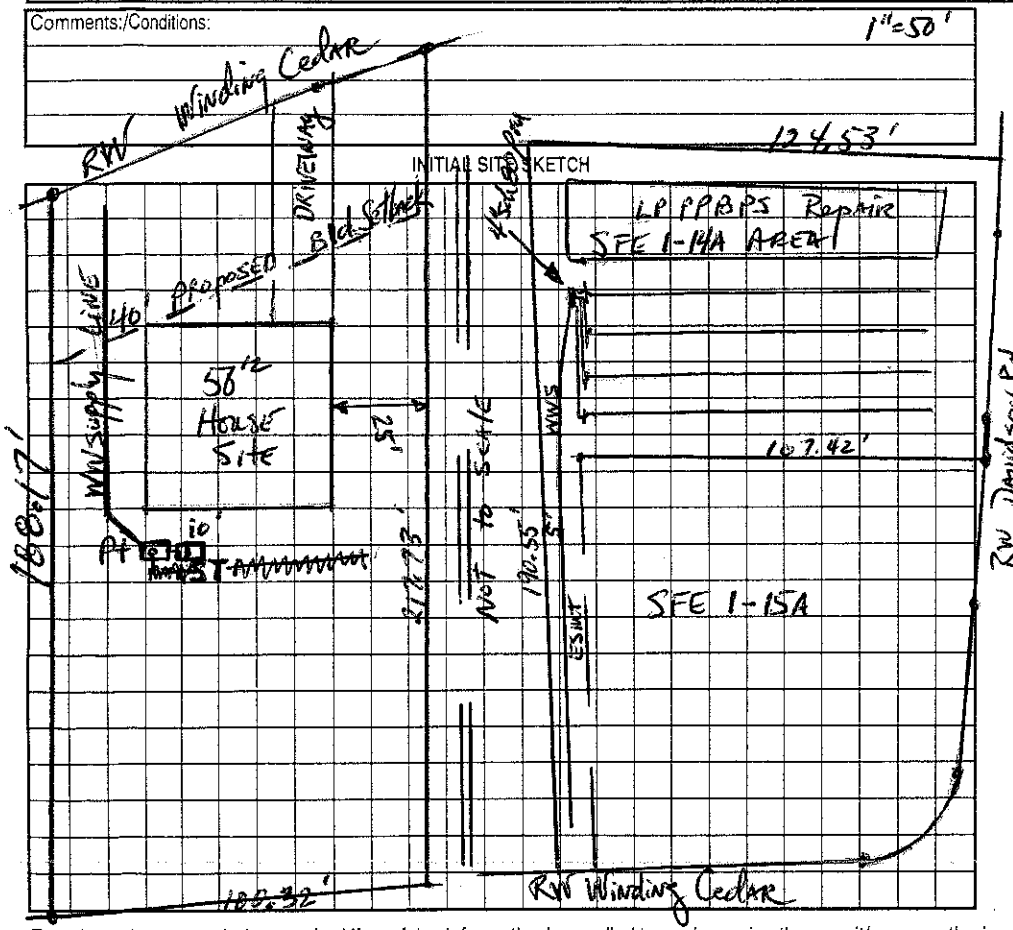

Comments:/Conditions:
14 POLYLAC FILTER
14 DRAWING INSTALLED AS DRAWN
15 V'D LINES & PRESSURE. NEED ELECTRICAL
15 LL 6-17-04 V'D ELECTRICAL

AS BUILT SKETCH

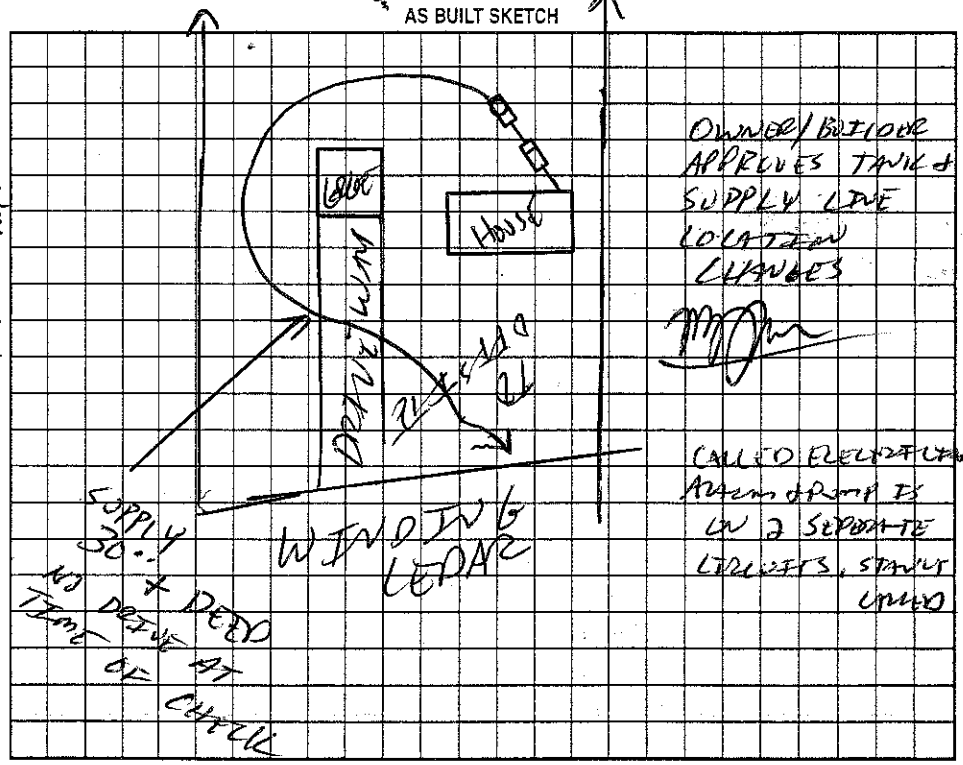

OWNER/BUILDER APPROVES TANK & SUPPLY LINE LOCATION CHANGES

CALLED ELECTRICIAN, ADMONISHED IS ON 2 SEPARATE CIRCUITS, STATED UNDER

Permit can be suspended or revoked if any false information is supplied toward securing the permit/any unauthorized changes are made to the site/any unauthorized changes are made in the installation of the system. Improvement Permit with plat valid without expiration. Improvement Permit with site plan valid for sixty months. Authorization to Construct is valid for a period equal to that of Improvement Permit – not to exceed sixty months.

Signed: _____ date 2/23/04 Installed by: ROWAN SEPTIC

Improvement Permit by: _____ date 2/20/04 Operation Permit by: _____ date 3-1-04

Authorization to Construct by: _____ date 2-23-04 Existing System Inspection by: _____ date _____

HEALTH DEPT. COPY: WHITE OWNER COPY (FINAL): YELLOW OWNER COPY (INITIAL): PINK