IREDELL COUNTY HEALTH DEPARTMENT

Statesville Phone TR 3-7271 Mooresville Phone NO 3-1271

PERMIT TO INSTALL SEPTIC TANK

Permit NO._____ Permit Date NOV 28 1960

Owner C. W. JAMES Address 4 #8 STA.

Installed By HAROLD HEDRICK. Address _____

Location of Property 0.8 DAT BUFFALO SHOALS ROAD


PAST DAVIDSON SER STA. 1st ROAD LEFT 2nd HOUSE

Tank		Capacity		Length of Lines		Fixtures	
Block	( )	800	( )	150'	( )	No. of Baths	(2)
Precast	(✓)	900	( )	175'	( )	Dishwasher	( )
		1000	(✓)	200'	( )	Garbage Grdr.	( )
		1100	( )	225'	(✓)	Auto-Washer	( )
		1200	( )	250'	( )	Other	_____
		Other	_____	Other	_____		

NOTIFY HEALTH DEPARTMENT AT LEAST EIGHT HOURS BEFORE TANK IS TO BE INSPECTED.

Final Inspection NOV 29 19 60 Approved (✓) Disapproved ( )

Remarks _____

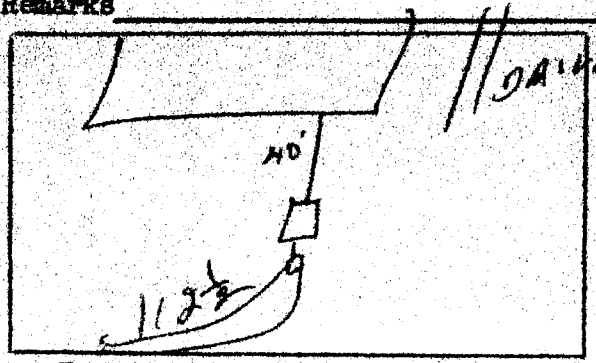

Sketch of Installation

Raymond G. Howe

Sanitarian