IREDELL COUNTY HEALTH DEPARTMENT

STATESVILLE 704-878-5305 — MOORESVILLE 704-664-5281

Existing System

IMPROVEMENT PERMIT / AUTHORIZATION TO CONSTRUCT / OPERATION PERMIT / EXISTING SYSTEM INSPECTION

PERMIT# 87359 PIN# 4723723073 A DATE Jan 31 2000

OWNER OR CONTRACTOR Glenn Irwin PHONE: Business _____ Home _____

ADDRESS _____

LOCATION Buffalo Shoals South (R) Ramblewood To end on Right

SUBDIVISION Ramblewood MHP BLOCK / SECTION _____ LOT 118 LOT AREA _____ SITE CLASS. _____ DESIGN FLOW 270 L.T.A.R. _____

Septic Tank: Existing Gallons; STB _____ Date _____
Pump Tank: Existing Gallons, PT _____ Date _____
Pump Make: _____ Model _____ Serial No. _____
Nitrification Field: No Fields ___ Square Feet _____ Linear Feet _____
No Lines _____ Trench Width _____ Max Trench Bottom Depth _____ Gravel Depth _____

☐ New System ☐ Repair System Type: I, II, III, IV, V, VI
System Description: _____
Repair System Description: _____
Maintenance Agreement Required: ☐ Yes ☐ No

☐ House/Mod. Home No. Bedrooms 2
☒ Mobile Home SW No. Bathrooms ___
☐ Business No. Employees ___
☐ Other _____
☐ Slab ☐ Crawl Space ☐ Basement w/plumbing ☐ Basement wo/plumbing


Water Supply:
☐ Individual
☒ Public
☐ Community

Comments:/Conditions:

Comments:/Conditions: No Sign of Failure
Recommend installing A NEMA 4X Box To enclose outlets for pump & Alarm
Alarm Mounted 2' ft Above

INITIAL SITE SKETCH

AS BUILT SKETCH

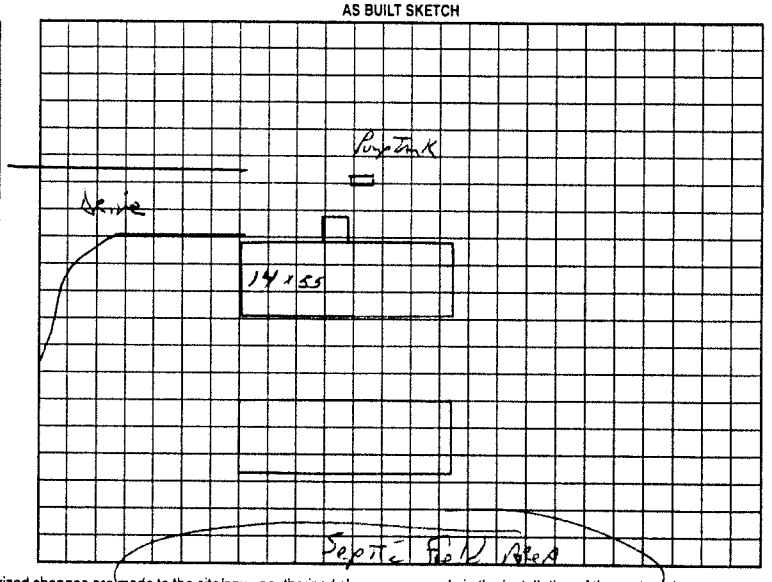

Permit can be suspended or revoked if any false information is supplied toward securing the permit/any unauthorized changes are made to the site/any unauthorized changes are made in the installation of the system. Improvement Permit with plat valid without expiration. Improvement Permit with site plan valid for sixty months. Authorization to Construct is valid for a period equal to that of Improvement Permit – not to exceed sixty months.

Signed: Wendy Bullock date 2/23/00

Improvement Permit by: _____ date _____

Authorization to Construct by: _____ date _____

Installed by: _____

Operation Permit by: _____ date _____

Existing System Inspection by: J C Potts date 2-22-00

HEALTH DEPT. COPY. WHITE OWNER COPY (FINAL). YELLOW OWNER COPY (INITIAL). PINK