IREDELL COUNTY HEALTH DEPARTMENT

STATESVILLE 704-878-5305 MOORESVILLE 704-664-5281

IMPROVEMENT PERMIT / CERTIFICATE OF COMPLETION / OPERATION PERMIT / EXISTING SYSTEM INSPECTION

PROPERTY DESCRIPTION NO. _____ DATE 7-24-97 TAX MAP NO. _____ Watershed: ☐ Yes ☐ No

OWNER OR CONTRACTOR Frank Davidson PHONE: Business _____ Home _____

ADDRESS _____

LOCATION Buffalo Shoales TR Ramblewood 1st + 2nd MH on Rt

SUBDIVISION Frank Davidson BLOCK / SECTION _____ LOT lot 104 LOT AREA _____ SITE CLASS. PS DESIGN FLOW _____ L.T.A.R. .3

Septic Tank: EX 1500 Gallons; STB _____ Date _____

Pump Tank: _____ Gallons; PT _____ Date _____

Pump Make: _____ Model _____ Serial No. _____

Nitrification Field: No Fields 1 Square Feet 468 Linear Feet 156

No Lines 2 Trench Width 36" Max Trench Bottom Depth 36" Gravel Depth N/A

☐ New System ☑ Repair System Type: I, II, III, IV, V, VI

System Description: _____

Repair System Description: Gravity Chambers

Maintenance Agreement Required: ☐ Yes ☐ No

☐ House/Mod. Home No. Bedrooms ____

☑ Mobile Home No. Bathrooms ____

☐ Business No. Employees ____

☑ Other 2 mobile Home Repair

☐ Slab ☐ Crawl Space ☐ Basement w/plumbing ☐ Basement wo/plumbing


Water Supply: ☐ Individual ☑ Community ☐ Public

Comments:


Repair for 1st + 2nd mH on Rt
lots 100 + 104

Comments:

INITIAL SITE SKETCH

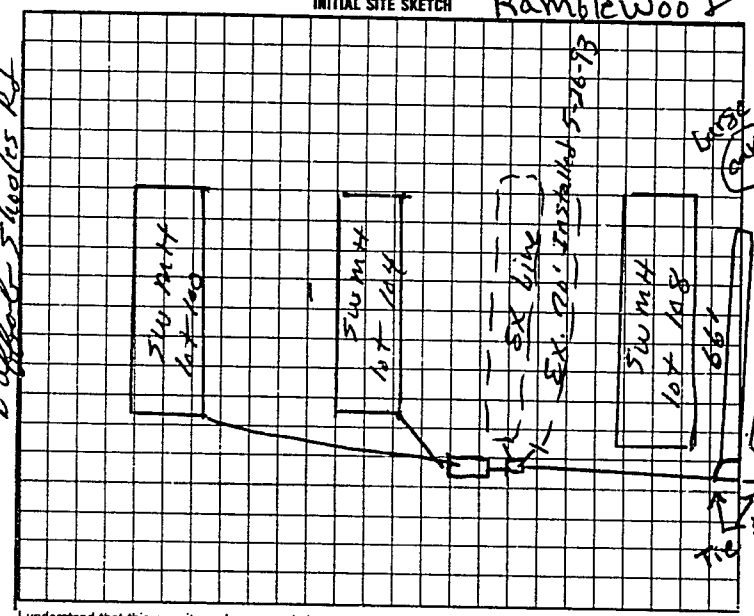

AS BUILT SKETCH

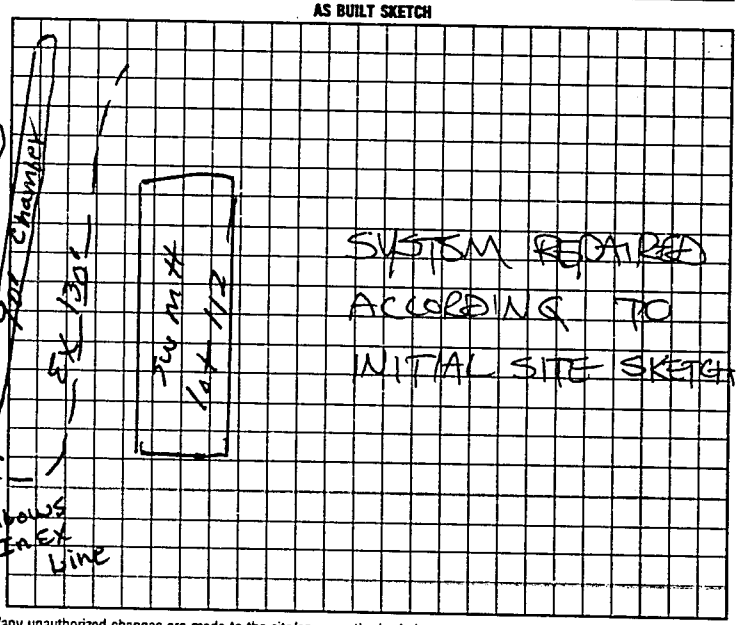

I understand that this permit can be suspended or revoked if any false information is supplied toward securing the permit/any unauthorized changes are made to the site/any unauthorized changes are made in the installation of the system. Improvement Permit is valid for 60 months from date of issuance.

Signed: Harry Key

Improvement Permit by: P.C. Moore date 7-24-97

Authorization to Occupy Existing System Inspected by: P.C. Moore date 7-24-97

to count

Installed by: TOMMY FRYE

Certificate of Completion by: _____ date _____

Operation Permit by: STEVE HEDRICK date 8-7-97

WHITE-DEPT COPY (WITH IMPROVEMENT PERMIT) INSPECTION COPY (FINAL) GREEN OWNER COPY (FINAL) YELLOW INSPECTION COPY (INITIAL): PINK OWNER COPY (INITIAL): GOLD

Authorization to count Expires 60 mos. from issue