IREDELL COUNTY HEALTH DEPARTMENT

Statesville Phone TR 3-7271 Mooresville Phone NO 3-1271

PERMIT TO INSTALL SEPTIC TANK

Permit NO. 321 Permit Date SEPT. 23 1970

Owner FRANK DAVIDSON TRAILER PARK Address STATESVILLE, N.C.

Installed By Mr. Sam Ostwalt Address TROUTMAN, N.C.

Location of Property BUFFALO SHOALS RD. PAST DAVIDSONS SERVICE STA. ON RIGHT.


2ND TANK ON RIGHT OF STREET.

Tank		Capacity		Length of Lines		Fixtures	
Block	( )	1000	(✓)	225'	( )	No. of Baths	(✓)
Precast	(✓)	1250	( )	250'	( )	Dishwasher	( )
		1500	( )	Other 198 6" Extra Tuff-Lite		Garbage Grdr.	( )
		Other				Other	

NOTIFY HEALTH DEPARTMENT AT LEAST EIGHT HOURS BEFORE TANK IS TO BE INSPECTED.

Final Inspection SEPT. 23 1970 Approved (✓) Disapproved ( )

Remarks CENTRAL WATER SYSTEM—

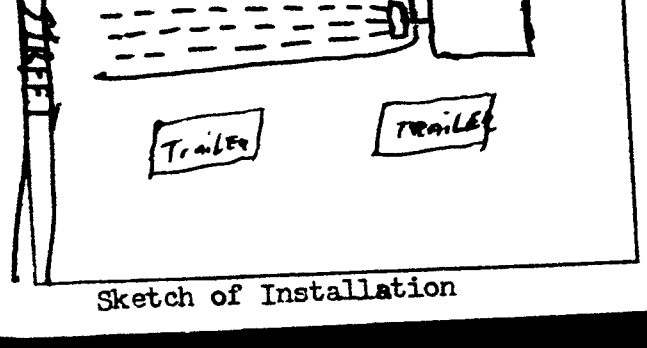

Sketch of Installation

Sanitarian