IREDELL COUNTY HEALTH DEPARTMENT

Statesville Phone TR 3-7271 Mooresville Phone NO 3-1271

PERMIT TO INSTALL SEPTIC TANK

Permit NO. 72 Permit Date 8-17 1972

Owner Davidson Trailer Park Address Statesville N C

Installed By Sam Ostwalt Address Statesville N.C.

Location of Property Out Buffalo Shoals Rd

Past Davidson Gro. Trailer Park


on R.

Tank		Capacity		Length of Lines		Fixtures	
Block	( )	1000	( )	225'	( )	No. of Baths	( )
Precast	(✓)	1250	(✓)	250'	( )	Dishwasher	( )
		1500	( )	Other 200'		Garbage Grdr.	( )
		Other				Other	

NOTIFY HEALTH DEPARTMENT AT LEAST EIGHT HOURS BEFORE TANK IS TO BE INSPECTED.

Final Inspection 8-17 1972 Approved (✓) Disapproved ( )

Remarks

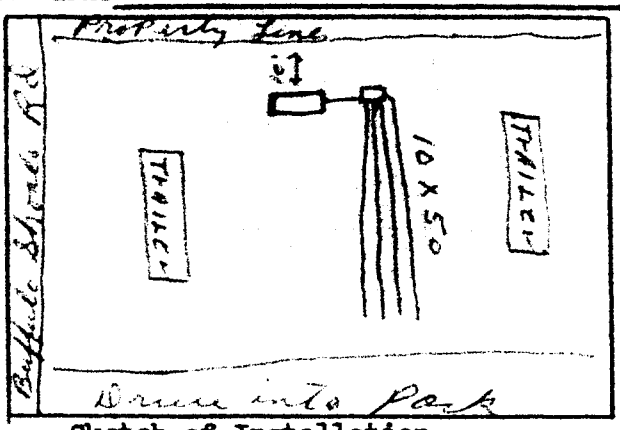

Sketch of Installation

Could Not get full amount of lines. Double amount of stone used - 12" under lines

E. G. Stevenson

Sanitarian