49016

IREDELL COUNTY HEALTH DEPARTMENT

STATESVILLE 704-878-5305 MOORESVILLE 704-664-5281

IMPROVEMENT PERMIT / CERTIFICATE OF COMPLETION / OPERATION PERMIT / EXISTING SYSTEM INSPECTION

PROPERTY DESCRIPTION NO. 17167 DATE 10-11-93 TAX MAP NO Pt. of 6C-A-5

OWNER OR CONTRACTOR Bruce Byrd PHONE Business Home 873-5814

ADDRESS 37 Deerfield Estates Statesville N.C. 28677

LOCATION I40W TL Old Mtn. Rd. TL Buffalo Shoals Rd. TL Entrance Rambleweed MHP. 2nd to last lot on R.

SUBDIVISION Rambleweed MHP BLOCK / SECTION LOT LOT AREA SITE CLASS Existing ~~LTAR~~

Water Supply: ☐ Individual ✓ Community ☐ Public

Septic Tank: Existing ~~Gallons: STB~~ ~~Date~~

Pump Tank: Existing ~~Gallons: PT~~ ~~Date~~

Nitrification Field: No Fields Existing ~~Square Feet~~ ~~Linear Feet~~

~~No Lines~~ ~~Trench Width~~ ~~Trench Depth~~ ~~Gravel Depth~~

☐ New System ☐ Repair System Type: I, II, III, IV, V, VI

System Description: Pump to conventional

Repair System Description:

Maintenance Agreement Required: ☐ Yes ✓ No

House/Mod. Home ✓ Mobile Home ☐ Business ✓ Other (2) 2 Bedroom SW MH's on one system

No. Bedrooms 2 No. Bathrooms 2 No. Employees —

Garbage Disposal: ☐ Yes ✓ No

Auto. Dishwasher: ☐ Yes ✓ No


Auto. Washing Machine: ✓ Yes ☐ No

Slab ✓ Crawl Space Basement w/plumbing Basement wo/plumbing

Comments: Two - 2 Bedroom SW MH's on one system. System shows no visible signs of malfunction at time of inspection. * Continuous drip of water in tank, need to check for leaks in homes. Lot vacant for period of time before this home was moved on.

INITIAL SITE SKETCH

AS BUILT SKETCH

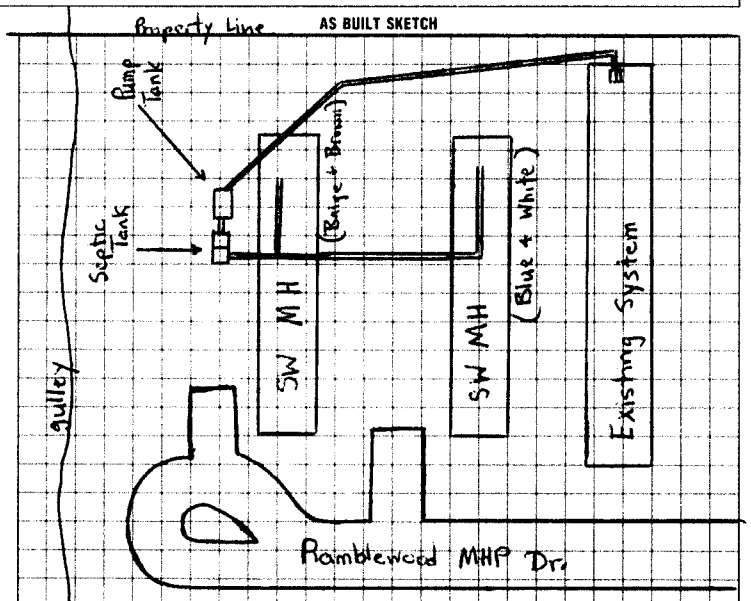

I understand that this permit can be suspended or revoked if any false information is supplied toward securing the permit/any unauthorized changes are made to the site/any unauthorized changes are made in the installation of the system. Improvement Permit is valid for 60 months from date of issuance.

☒ Well

Signed:

Improvement Permit by: date

Existing System Inspection by: Michael J. Dennis date 10-11-93

Installed by

Certificate of Completion by date

Operation Permit by date

HEALTH DEPT. COPY WHITE INSPECTION COPY (FINAL) GREEN OWNER COPY (FINAL) YELLOW INSPECTION COPY (INITIAL) PINK OWNER COPY (INITIAL) GOLD