IREDELL COUNTY HEALTH DEPARTMENT - *ENVIRONMENTAL HEALTH* ☐ STATESVILLE OFFICE 704-878-5305 ☐ MOORESVILLE OFFICE 704-664-5281

IMPROVEMENT PERMIT / AUTHORIZATION TO CONSTRUCT / OPERATION PERMIT / EXISTING SYSTEM INSPECTION

PERMIT # REPAIR PIN # 4723-73-8289 DATE MAY 11, 2011

OWNER CAROL L. CRUMP APPLICANT: SAME PHONE: Home/Cell # 704-528-5800 Business #

SITE ADDRESS 1248 BUFFALO SHOALS RD STVL. OWNER / APPLICANT ADDRESS 1256 BUFFALO SHOALS RD STATESVILLE, 28677

SITE DIRECTIONS BUFFALO SHOALS ROAD SW TO BOX # 1248 ON RIGHT BEHIND CHARIS CHURCH

SUBDIVISION 1060 BLOCK / SECTION LOT # LOT AREA 3.874 ACRES DESIGN FLOW 240 L.T.A.R. 0.30 GPD/FT²

Septic Tank EXISTING Gallons: STB 2062 Date plastic

Pump Tank Gallons: P T Date

Pump Make Model Serial #

No. Nitrification Fields: 1 No. Lines 3 Linear Feet 200

Trench Width 36" Max. Trench Bottom Depth 36" Gravel Depth N/A

☐ New System ☑ Repair ☐ Expansion System Type I II III IV V VI

System Description:

Repair System Description: 25% REDUCTION, GRAVITY

Maintenance Agreement Required ☐ YES ☑ NO

☑ GRAVITY ☐ PRESSURE

☑ Residence No. Bedrooms 1

☐ Business No. Persons

☐ Other No. Employees


☐ Slab ☑ Crawl Space

☐ Basement w/plumbing ☐ Basement w/o plumbing

Water Supply: ☑ Private WELL ☐ Public ☐ Community

Comments / Conditions: INSTALL NEW 25% REDUCTION SYSTEM ON CONTOUR AS SHOWN USING SERIAL DISTRIBUTION

INITIAL SITE SKETCH

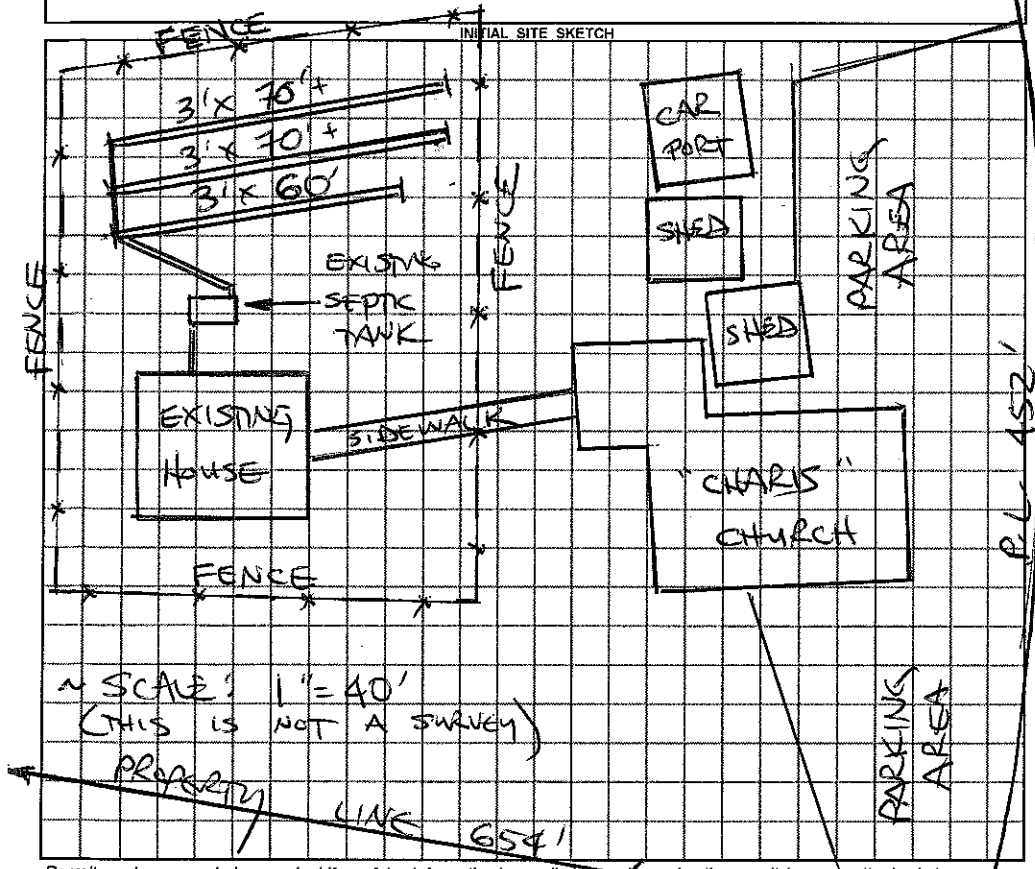

AS BUILT SKETCH



Permit can be suspended or revoked if any false information is supplied toward securing the permit / any unauthorized changes are made to the site / any unauthorized changes are made in the installation of the system.

☐ ***IMPROVEMENT PERMIT*** with plat valid without expiration. ☑ ***IMPROVEMENT PERMIT*** with plat valid without expiration, site plan valid 60 mo. ☑ ***AUTHORIZATION TO CONSTRUCT*** valid for period equal to IMPROVEMENT PERMIT--not to exceed 60 mo.

Owner / Applicant Signature: Date 5/17/11 Installed by: A-1 Backhoe

IMPROVEMENT PERMIT by: STEVE HENDRICK REHS Date 5/11/2011 OPERATION PERMIT by: REHS Date 5-24-11

AUTHORIZATION TO CONSTRUCT by: STEVE HENDRICK REHS Date 5/11/2011 Existing System Inspected by: REHS Date

YOU SHOULD CONTACT A LOCATOR SERVICE PRIOR TO ANY EXCAVATION

White Copy – Environmental Health YELLOW COPY (Final) Owner / Applicant PINK COPY (Initial) Owner / Applicant