IREDELL COUNTY HEALTH DEPARTMENT

Statesville Phone TR 3-7271 Mooresville Phone NO 3-1271

PERMIT TO INSTALL SEPTIC TANK

Permit NO. 11 L. Isenhour Blvd Permit Date 10 - 2 - 1962

Owner Mrs. Clyde Dixon Address Buffalo Shoals Rd.

Installed By C Hoke Address


Location of Property Corner 1004 and 1366 - Boston Hgts.

Tank		Capacity		Length of Lines		Fixtures	
Block	( )	800	( )	150'	( )	No. of Baths	(2)
Precast	(✓)	900	( )	175'	( )	Dishwasher	( )
		1000	(✓)	200'	( )	Garbage Grdr.	( )
		1100	( )	225'	(✓)	Auto-Washer	(✓)
		1200	( )	250'	( )	Other	
		Other		Other			

NOTIFY HEALTH DEPARTMENT AT LEAST EIGHT HOURS BEFORE TANK IS TO BE INSPECTED.

Final Inspection 10-2 1962 Approved (✓) Disapproved ( )

Remarks well 75' "[redacted]"

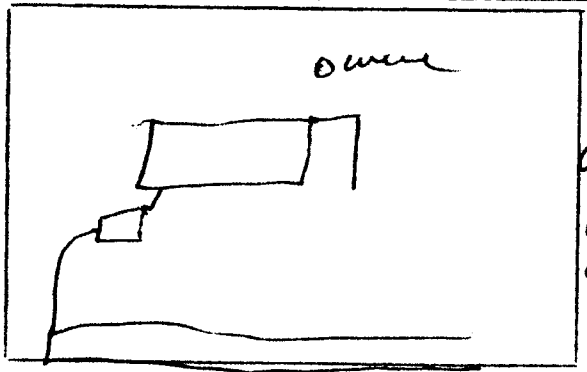

Sketch of Installation

Elder. pushed stumps trash on lot and covered with dirt dug into logs stumps used but only thing could do. good layout otherwise

R.S.

Sanitarian