IREDELL COUNTY HEALTH DEPARTMENT

Statesville Office (704) 878-5305 Mooresville Office (704) 660-3625 PERMIT # 215165

IMPROVEMENT PERMIT / AUTHORIZATION TO CONSTRUCT / OPERATION PERMIT / EXISTING SYSTEM

PIN # 4723749975

APPLICANT: Bill Auton APPLICANT ADDRESS: 273 Gilbert Rd

SITE ADDRESS: 116 Chatfield LP PHONE: 704-682-5657 ALT. PHONE: N/A

SITE DIRECTIONS: Buffalo Shoals Rd to Chatfield LP

SUBDIVISION: Mary E Bostian SECTION: N/A LOT # 55-61 LOT AREA: 0.30 acres DESIGN FLOW: 240gpd L.T.A.R.: Existing

Septic Tank 1000 (gal) STB 760-1000 Date 9-8
Pump Tank (gal) PT Date
Pump Make Model Serial #
Nitrification Fields 6x # Lines 6x Linear Ft: 6x
Trench Width 6x Max. Trench Bottom Depth 6x Gravel Depth 6x


☐ New System ☑ Repair ☐ Expansion System Type: I (II) III IV V VI
System Description: TANK
Repair System Description:
Maintenance Agreement Required: ☐ YES ☑ NO
☐ GRAVITY ☐ PRESSURE

☑ Residence No. Bedrooms 2
☐ Business No. Persons 4
☐ Other No. Employees
☐ Slab ☑ Crawl Space
☐ Basement w/plumbing ☑ Basement w/o plumbing

Water Supply: ☑ Private ☐ Public ☐ Community

Comments / Conditions: Pump & Crush existing septic tank. Set new septic tank @ location shown below & connect to existing drainfield.

INITIAL SITE SKETCH

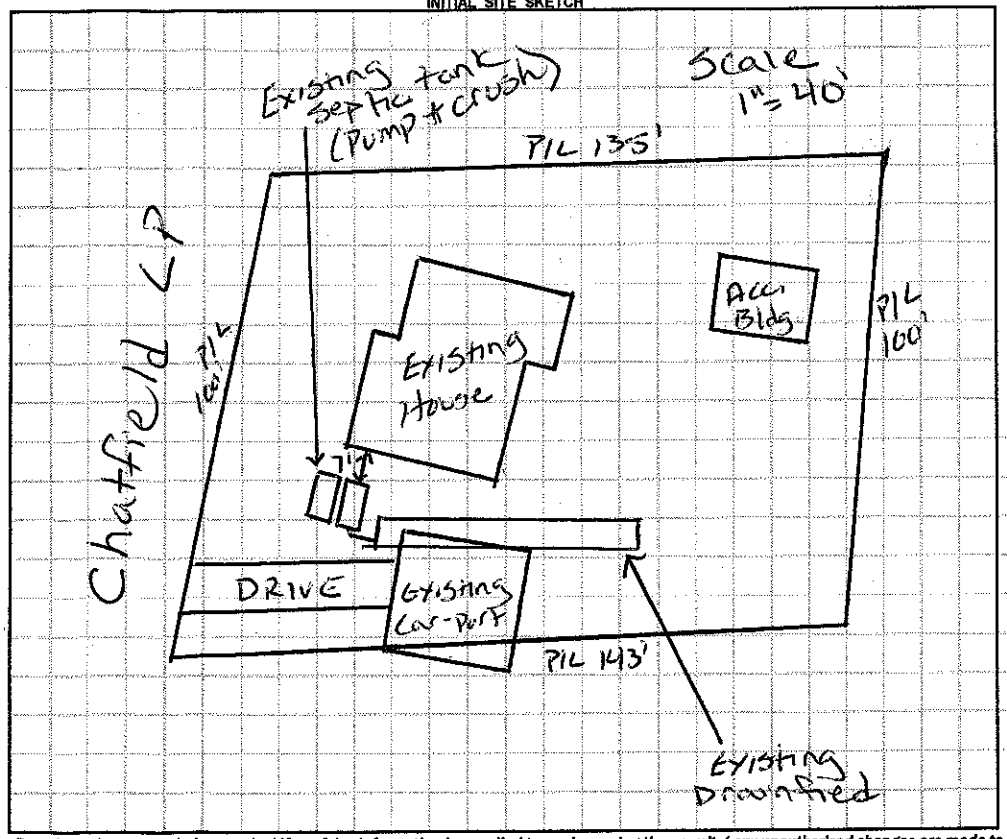

AS BUILT SKETCH

- Red Polylok filter installed
- Risers installed above Grade
- Installed as drawn

Permit can be suspended or revoked if any false information is supplied toward securing this permit / any unauthorized changes are made to the site / any unauthorized changes are made in the installation of the system. **CONTACT A LOCATOR SERVICE PRIOR TO ANY EXCAVATION**

☐ **IMPROVEMENT PERMIT** *with plat valid without expiration.* ☑ **IMPROVEMENT PERMIT** *with site plan valid for 60 mos.* ☑ **AUTHORIZATION TO CONSTRUCT** *valid for period equal to IMPROVEMENT PERMIT--not to exceed 60 mo.*

Owner / Applicant Signature: Bill Auton Date: 12-2-15 Installed by: Lentz Wastewater

IMPROVEMENT PERMIT by: Justin Henderson Date: 12-2-15 OPERATION PERMIT by: Justin Henderson Date: 12-4-15

AUTHORIZATION TO CONSTRUCT by: Justin Henderson Date: 12-2-15 Existing System Inspected by: Date:

Health Dept. Copy - WHITE Applicant (Final Approval) - YELLOW Applicant (Conditional Approval) - PINK