IREDELL COUNTY HEALTH DEPARTMENT

Statesville Phone TR 3-7271 Mooresville Phone NO 3-1271

Permit NO. _____ PERMIT TO INSTALL SEPTIC TANK

Permit Date Oct 24 1962

Owner Hope Bro. Bldrs. Address Bostian Hights

Installed By C Hoke Address _____


Location of Property Last street to right before Creek toward River 1st on Right.

| Tank | | Capacity | | Length of Lines | | Fixtures | |
|---|---|---|---|---|---|---|---|
| Block | ( ) | 800 | ( ) | 150' | ( ) | No. of Baths | (1) |
| Precast | (✓) | 900 | ( ) | 175' | ( ) | Dishwasher | ( ) |
| | | 1000 | (✓) | 200' | ( ) | Garbage Grdr. | ( ) |
| | | 1100 | ( ) | 225' | (✓) | Auto-Washer | ( ) |
| | | 1200 | ( ) | 250' | ( ) | Other | (✓) |
| | | Other _____ | | Other _____ | | | |

NOTIFY HEALTH DEPARTMENT AT LEAST EIGHT HOURS BEFORE TANK IS TO BE INSPECTED.

Final Inspection 10-24 1962

Remarks well 65' Approved (✓) Disapproved ( )

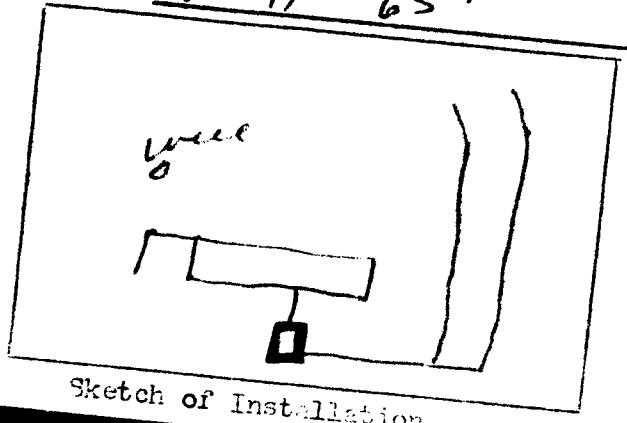


Sketch of Installation

R. A.

Sanitarian