IREDELL COUNTY HEALTH DEPARTMENT

IMPROVEMENT PERMIT / AUTHORIZATION TO CONSTRUCT / OPERATION PERMIT / EXISTING SYSTEM INSPECTION

STATESVILLE 704-878-5305 — MOORESVILLE 704-664-5281

1" = 25' 1" = 8' 2" = 15' 2" = 16' 3" = 2nd Danny LAMBERT 902-4207

PERMIT# REPAIR PIN# 4723-75-4881

OWNER OR APPLICANT BARBARA CHILDERS PHONE: Business 704-878-3188 Home 871-5395 DATE 6-17-08

ADDRESS 247 Bostian LAKE Rd Statesville NC 28677

LOCATION BUFFALO SHOALS WEST @ Bostian LAKE AT Y BEAR Right A4 END ON RT

SUBDIVISION Bostian Heights BLOCK / SECTION ____ LOT W5 6 LOT AREA ± 1 ACRE SITE CLASS. PS DESIGN FLOW 240 L.T.A.R. .25

NEW TANK

Septic Tank: ~~1000~~ 1000 Gallons: STB 1001 Date 5-26-08

Pump Tank: ~~1000~~ Gallons: PT ____ Date ____

Pump Make: ____ Model ____ Serial No. ____

Nitrification Field: No. Fields 1 Square Feet ± 960' Linear Feet 280'

No. Lines 3 Trench Width 36" Max Trench Bottom Depth 18"

☐ New System ☒ Repair ☐ Expansion System Type: I II III IV V VI

System Description: GRAVITY 2 SYSTEMS

Repair System Description: ____

Maintenance Agreement Required: ☐ Yes ☒ No

Gravel Depth N/A ☒ Gravity ☐ Pressure ☐ Slab ☒ Crawl Space ☐ Basement w/plumbing ☐ Basement wo/plumbing


☒ House/Mod. Home ☐ Mobile Home ☐ Business ☐ Other

No. Bedrooms 2 No. Persons 4 No. Employees ____

Water Supply: ☒ Individual ☐ Public ☐ Community


Comments/Conditions: (1) Install Lines on Contours & Maintain Setbacks (2) If old tank is used inspect Tee & Replace if necessary. (3) IF OLD TANK CAN NOT BE USED, Pump, CRUSH, & FILL OLD TANK & INSTALL ANEW 1000 Gallon

INITIAL SITE SKETCH

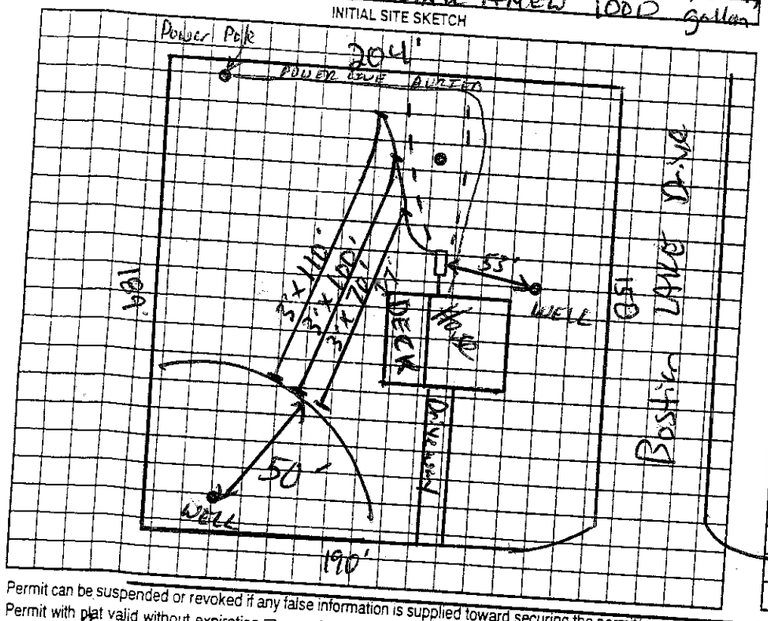

Comments/Conditions: TANK. (1) Keep system 50' from well. 2 WELLS ARE ON PROPERTY (3) Start 18" trench bottom at lowest point in contour. 18" trench bottom is on the high side of the ditch. (4) END CAPS CAN BE USED FOR distribution due to tight space (5) Disconnect OLD SYSTEM (6) Lots Have been combined. THIS Permit Serves As Notice of Violation & MUST BE Reported Within 30 DAYS

AS BUILT SKETCH

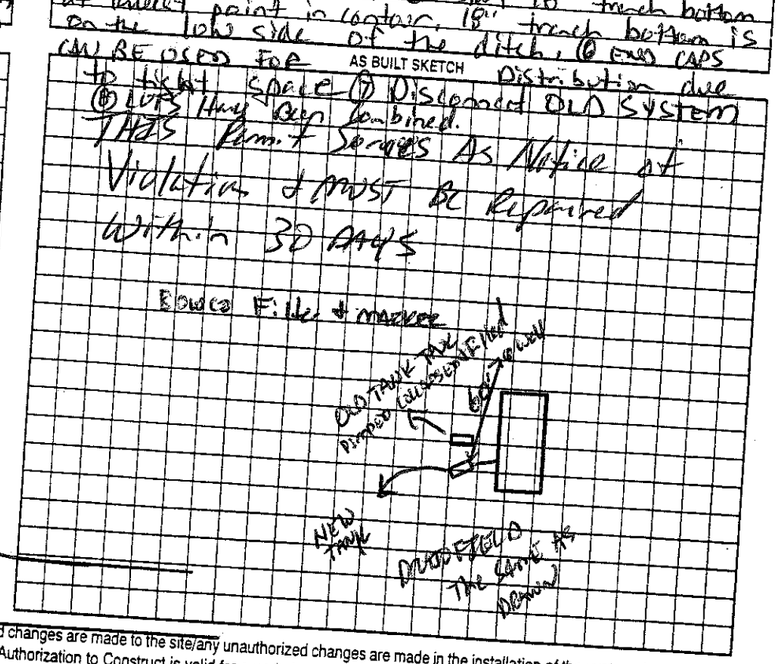

Permit can be suspended or revoked if any false information is supplied toward securing the permit/any unauthorized changes are made to the site/any unauthorized changes are made in the installation of the system. Improvement Permit with plat valid without expiration ☐ Improvement Permit with site plan valid for sixty months ☒ Authorization to Construct is valid for a period equal to that of Improvement Permit – not to exceed sixty months.

Signed: Barbara Childers

Improvement Permit by: _____ date 6-19-08

Authorization to Construct by: _____ date 6-17-08

Installed by: Union Grove Septic TANK Service #1793

Operation Permit by: _____ date 7-8-08

Existing System Inspection by: _____ date ____

HEALTH DEPT. COPY: WHITE OWNER COPY (FINAL): YELLOW OWNER COPY (INITIAL): PINK