IREDELL COUNTY HEALTH DEPARTMENT

STATESVILLE 704-878-5305 MOORESVILLE 704-664-5281

IMPROVEMENT PERMIT / AUTHORIZATION TO CONSTRUCT / OPERATION PERMIT / EXISTING SYSTEM INSPECTION

PERMIT # Repair PIN # 4723757063 DATE 4-21-09

OWNER or APPLICANT James Bush PHONE: Business Home: 704 235 8111

OWNER or APPLICANT ADDRESS 104 Chatfield Lp

LOCATION / DIRECTIONS From 140 W, turn (S) on Old Mtn. Rd., (L) on Buffalo Shoals, on (R) on 2nd Chatfield Lp Rd.

SUBDIVISION ~~Ada~~ Bostian Heights BLOCK / SECTION LOT # 42 LOT AREA DESIGN FLOW Ex. L.T.A.R. Ex

Septic Tank 1000 Gallons: STB 1000 Date 1-24-09

Pump Tank Gallons: P T Date

Pump Make Model Serial #

Nitrification Field No Fields Ex. No Lines Ex. Linear Feet Ex

Trench Width Ex. Max. Trench Bottom Depth Ex Gravel Depth Ex

☐ New System ☒ Repair ☐ Expansion System Type I (II) III IV V VI

System Description: New Tank

Repair System Description:

Maintenance Agreement Required ☐ YES ☒ NO

☒ GRAVITY ☐ PRESSURE


☒ Residence No. Bedrooms Ex. ☐ Business No. Persons ☐ Other No. Employees ☐ Slab ☒ Crawl Space ☐ Basement w/plumbing ☐ Basement w/o plumbing

Water Supply: ☒ Private ☐ Public ☐ Community

Comments / Conditions

Comments / Conditions

INITIAL SITE SKETCH

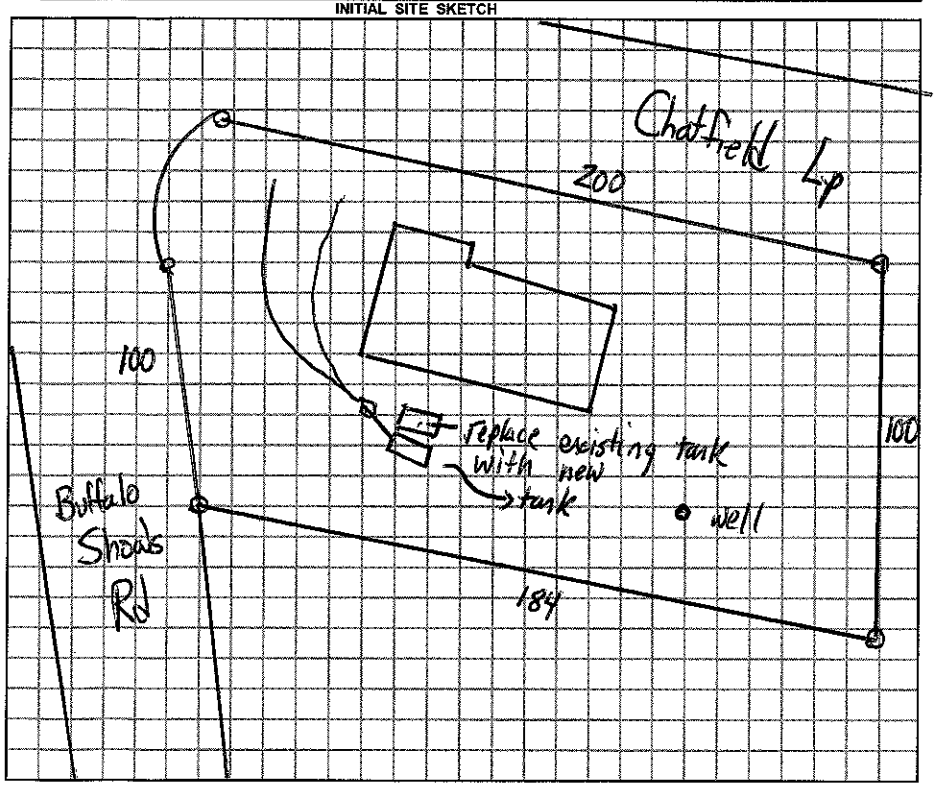

AS BUILT SKETCH

Permit can be suspended or revoked if any false information is supplied toward securing the permit / any unauthorized changes are made to the site / any unauthorized changes are made in the installation of the system.

☐ *IMPROVEMENT PERMIT w / plat valid without expiration.* ☒ *IMPROVEMENT PERMIT w / site plan valid for 60 mos.* ☒ *AUTHORIZATION TO CONSTRUCT valid for period equal to IMPROVEMENT PERMIT-not to exceed 60 mo.*

Owner / Applicant Signature: Date 4-23-09

Improvement Permit by: Date 4-21-09

Authorzation to Construct by: Date 4-21-09

YOU SHOULD CONTACT A LOCATOR SERVICE PRIOR TO ANY EXCAVATION.

Installed by: Jared Lentz

Operation Permit by: Date: 4-22-09

Existing System Inspected by: Date:

WHITE COPY Environmental Health YELLOW COPY (Final) Owner / Applicant PINK COPY (Initial) Owner / Applicant