IREDELL COUNTY HEALTH DEPARTMENT

STATESVILLE 704-878-5305 MOORESVILLE 704-664-5281

IMPROVEMENT PERMIT / CERTIFICATE OF COMPLETION / OPERATION PERMIT / EXISTING SYSTEM INSPECTION

PROPERTY DESCRIPTION NO. Repair DATE 3-23-95 TAX MAP NO. Repair Watershed: ☐ Yes ☑ No

OWNER OR CONTRACTOR Alan Burgin PHONE: Business 872-9841 Home 878-9275

ADDRESS P.O Box [redacted] 5403 Statesville, N.C. 28687

LOCATION I40W TL Hwy 90 TR Buffalo Shoals Rd. TL Arey Rd. First house on R facing Buffalo Shoals Rd.

SUBDIVISION NA BLOCK / SECTION — LOT — LOT AREA ≈1.6 acre SITE CLASS. Repair DESIGN FLOW 240 L.T.A.R. Repair

Septic Tank: Existing Gallons; STB — Date —
Pump Tank: — Gallons; PT — Date —
Pump Make: — Model — Serial No. —
Nitrification Field: No Fields 2 Square Feet 630 Linear Feet 210'
No Lines 2 Trench Width 36" Max Trench Bottom Depth 24" Gravel Depth 12"

☐ New System ☑ Repair System Type: I, II, III, IV, V, VI
System Description: conventional, gravity fed
Repair System Description: —
Maintenance Agreement Required: ☐ Yes ☑ No


☑ House/Mod. Home No. Bedrooms 2
☐ Mobile Home No. Bathrooms 1
☐ Business No. Employees —
☐ Other —
☐ Slab ☐ Crawl Space ☐ Basement w/plumbing ☑ Basement wo/plumbing

Water Supply: ☑ Individual ☐ Community ☐ Public

Comments: Install D-box at tank, if there is not an existing one. Feed existing drain lines first, then run ≈85 of schedule 40 PVC to another D-box. Run 2 (105' lines) from the D-box. Keep system shallow (no deeper than 24" to trench bottom). Keep lines and trenches on contour. Keep system 6' from existing system, 10' from all Property lines, and max feasable distance from any well and no closer than 50'. Check integrity of Septic tank, add new sanitary tee if needed.

Comments:
1. New Sch 40 Tee Added
2. Trenches were 110' long Each
3. Existing lines were not usable Therefore they were not hooked up

INITIAL SITE SKETCH

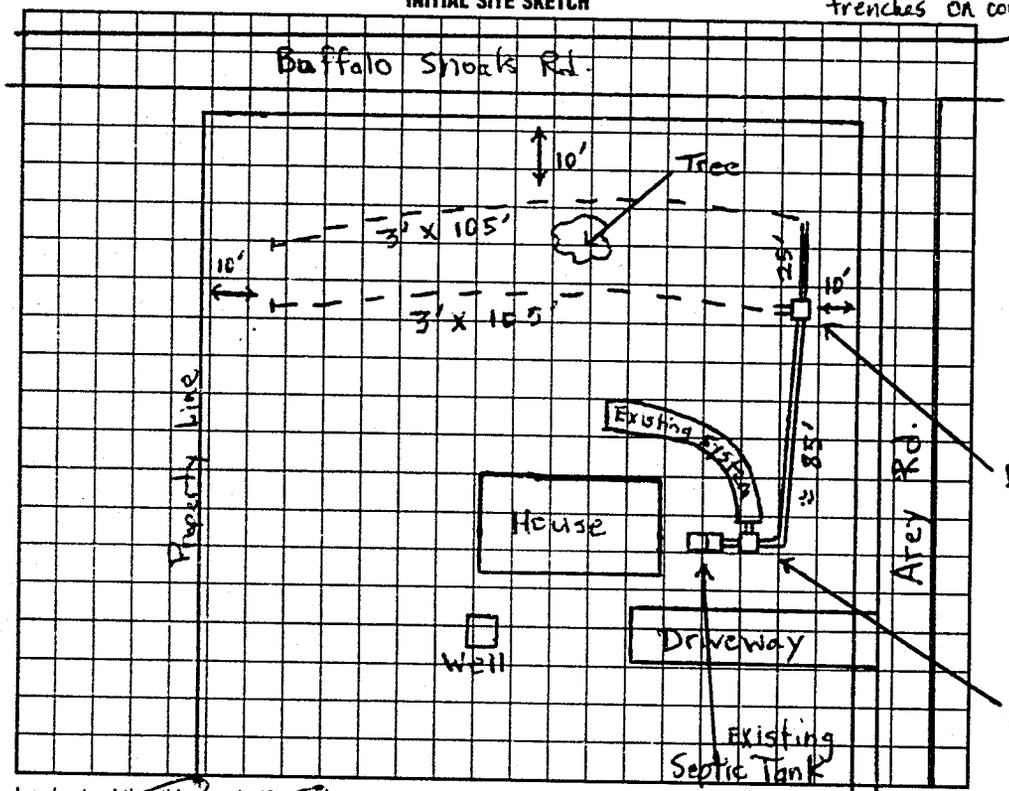

AS BUILT SKETCH

I understand that this permit can be suspended or revoked if any false information is supplied toward securing the permit/any unauthorized changes are made to the site/any unauthorized changes are made in the installation of the system. Improvement Permit is valid for 60 months from date of issuance.

Signed: —

Improvement Permit by: J. Michael J. Dennis date 3-23-95

Existing System Inspection by: — date —

Installed by: AAA Enterprises

Certificate of Completion by: J. C. Moore date 10-27-95

Operation Permit by: — date —

HEALTH DEPT. COPY: WHITE INSPECTION COPY (FINAL) GREEN OWNER COPY (FINAL): YELLOW INSPECTION COPY (INITIAL): PINK OWNER COPY (INITIAL): GOLD