Ad #175, 6/8/96 M.B #21427 61351

IREDELL COUNTY HEALTH DEPARTMENT

STATESVILLE 704-878-5305 MOORESVILLE 704-664-5281

IMPROVEMENT PERMIT / CERTIFICATE OF COMPLETION / OPERATION PERMIT / EXISTING SYSTEM INSPECTION

PROPERTY DESCRIPTION NO. 21427 DATE 5-13-96 TAX MAP NO. 62-14-A-68 Watershed: ☐ Yes ☑ No

OWNER OR CONTRACTOR Hope Brothers PHONE: Business 872-4111 Home

ADDRESS 1170 Barkley Rd Sta.

LOCATION ~~SR TR~~ Buffalo Shoals Rd TR Airport Rd TL Parker Loop TL Delight Land

SUBDIVISION Lakewood BLOCK / SECTION LOT 68 LOT AREA 100'X200' SITE CLASS. PS DESIGN FLOW 360 L.T.A.R. .3

Septic Tank: 1000 Gallons; STB 1012 Date 6-17-96

Pump Tank: Gallons; PT Date

Pump Make: Model Serial No.

Nitrification Field: No Fields 1 Square Feet 900 Linear Feet 300

No Lines 4 Trench Width 36" Max Trench Bottom Depth 36" Gravel Depth N/A

☑ New System ☐ Repair System Type: I, II, III, IV, V, VI

System Description: Gravity Chambers

Repair System Description: Pump To Chambers

Maintenance Agreement Required: ☐ Yes ☐ No

☑ House/Mod. Home No. Bedrooms 3

☐ Mobile Home No. Bathrooms 2

☐ Business No. Employees

☐ Other

☑ Slab ☑ Crawl Space ☐ Basement w/plumbing ☐ Basement wo/plumbing


Water Supply: ☐ Individual ☐ Community ☑ Public

Comments:

700'

Comments:

INITIAL SITE SKETCH

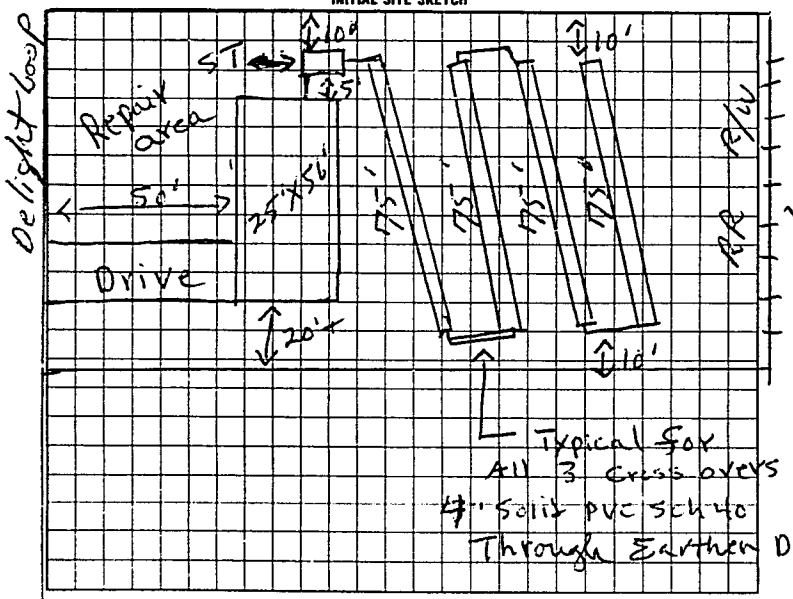

AS BUILT SKETCH

Installed As Shown

I understand that this permit can be suspended or revoked if any false information is supplied toward securing the permit/any unauthorized changes are made to the site/any unauthorized changes are made in the installation of the system.

Signed

Improvement Permit by: L. C. Moore date 5-13-96

Existing System Inspection by: L. C. Moore date 5-13-96

Authorization to Const.

Installed by: Arnie Duncan

Certificate of Completion by: Mark C Ousley RS date 9-23-96

Operation Permit by date

HEALTH DEPT COPY WHITE INSPECTION COPY (FINAL) GREEN OWNER COPY (FINAL) YELLOW INSPECTION COPY (INITIAL) PINK OWNER COPY (INITIAL) GOLD

Authorization to Const. Expires 6 mos from issue

SS 8000