46841

IREDELL COUNTY HEALTH DEPARTMENT

STATESVILLE 704-878-5305 MOORESVILLE 704-664-5281

IMPROVEMENT PERMIT / CERTIFICATE OF COMPLETION / OPERATION PERMIT / EXISTING SYSTEM INSPECTION

PROPERTY DESCRIPTION NO. 16128 DATE 9-13-93 TAX MAP NO. 6E-17-A-70

OWNER OR CONTRACTOR Hope Bros. PHONE: Business 872-4111 Home

ADDRESS

LOCATION Airport Rd TL Parker Lake Loop Rd. TL Lakewood Dr 2nd Lot on L after 90° turn.

SUBDIVISION Lakewood Estates BLOCK / SECTION LOT 70 LOT AREA SITE CLASS. P.S. L.T.A.R. .4 gpd/ft²

Water Supply: ☐ Individual ☐ Community ☑ Public

Septic Tank: 1000 Gallons: STB 359 Date 5-3-93

Pump Tank: — Gallons: PT — Date —

Nitrification Field: No Fields 1 Square Feet 900 Linear Feet 300'

No Lines 3 Trench Width 36" Trench Depth 24"-36" Gravel Depth 12"

☑ New System ☐ Repair System Type: I. II. III. IV. V. VI

System Description: Conventional gravity

Repair System Description: pump to conventional

Maintenance Agreement Required: ☐ Yes ☐ No

☑ House/Mod. Home ☐ Mobile Home ☐ Business ☐ Other

No. Bedrooms 3 No. Bathrooms 2 No. Employees —

Garbage Disposal: ☐ Yes ☑ No

Auto. Dishwasher: ☐ Yes ☐ No

Auto. Washing Machine: ☑ Yes ☐ No


Other

☐ Slab ☑ Crawl Space ☐ Basement w/plumbing ☐ Basement wo/plumbing

Comments Recommend surface diversion ditch to reroute water. 100% Repair, partial below system (conventional, gravity) remainder pump to conventional

INITIAL SITE SKETCH

AS BUILT SKETCH

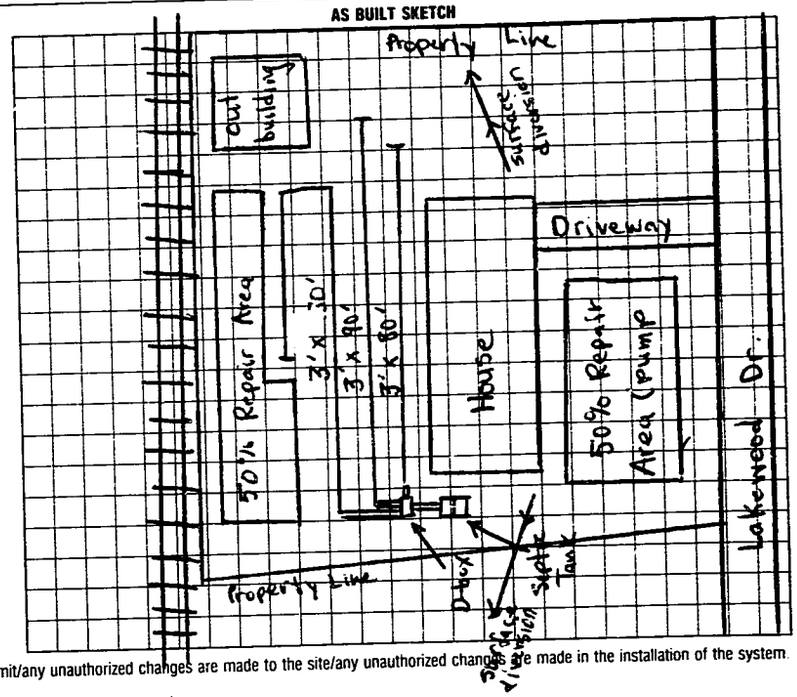

I understand that this permit can be suspended or revoked if any false information is supplied toward securing the permit/any unauthorized changes are made to the site/any unauthorized changes are made in the installation of the system. Improvement Permit is valid for 60 months from date of issuance.

Signed:

Improvement Permit by: Michael J. Dennis date 4-12-93

Existing System Inspection by: date

Installed by: Hope Bros.

Certificate of Completion by: Michael J. Dennis date 9-13-93

Operation Permit by: date

HEALTH DEPT. COPY: WHITE INSPECTION COPY (FINAL): GREEN OWNER COPY (FINAL): YELLOW INSPECTION COPY (INITIAL): PINK OWNER COPY (INITIAL): GOLD