IREDELL COUNTY HEALTH DEPARTMENT

STATESVILLE 704-878-5305 MOORESVILLE 704-664-5281 (C1)

IMPROVEMENT PERMIT / AUTHORIZATION TO CONSTRUCT / OPERATION PERMIT / EXISTING SYSTEM INSPECTION

PERMIT# 120852 PIN# 4723-77-3429 DATE 5-12-04

OWNER OR CONTRACTOR PERRY STEVE MILLER PHONE: Business 704-539-5109 Home 704-657-7462

ADDRESS P.O. BOX 5462 STATESVILLE, NC 28677

LOCATION US 70 WEST, TL, AIRPORT ROAD, TL DEERFIELD LANE, 3RD LOT ON RIGHT

SUBDIVISION DEERFIELD EST, BLOCK / SECTION ____ LOT 39 LOT AREA 1.25 ACRES SITE CLASS. PS, DESIGN FLOW 240 L.T.A.R. EXISTING

Septic Tank: 1000 Gallons; STB ____ Date ____

Pump Tank: ____ Gallons; PT ____ Date ____

Pump Make: ____ Model ____ Serial No. ____

Nitrification Field: No Fields 1 Square Feet ____ Linear Feet ____

No Lines THREE Trench Width ____ Max Trench Bottom Depth ____ Gravel Depth ____

☐ New System ☐ Repair System Type: I, (II), III, IV, V, VI

System Description: CONVENTIONAL, GRAVITY

Repair System Description: ____

Maintenance Agreement Required: ☐ Yes ☑ No

☐ House/Mod. Home No. Bedrooms 2

☑ Mobile Home No. Bathrooms 2

☐ Business No. Employees ____

☐ Other ____


☐ Slab ☑ Crawl Space ☐ Basement w/plumbing ☐ Basement wo/plumbing

Water Supply: ☐ Individual ☑ Public ☐ Community


Comments:/Conditions:

Comments:/Conditions: SYSTEM UNDERSIZED ACCORDING TO TODAY'S STANDARDS

INITIAL SITE SKETCH

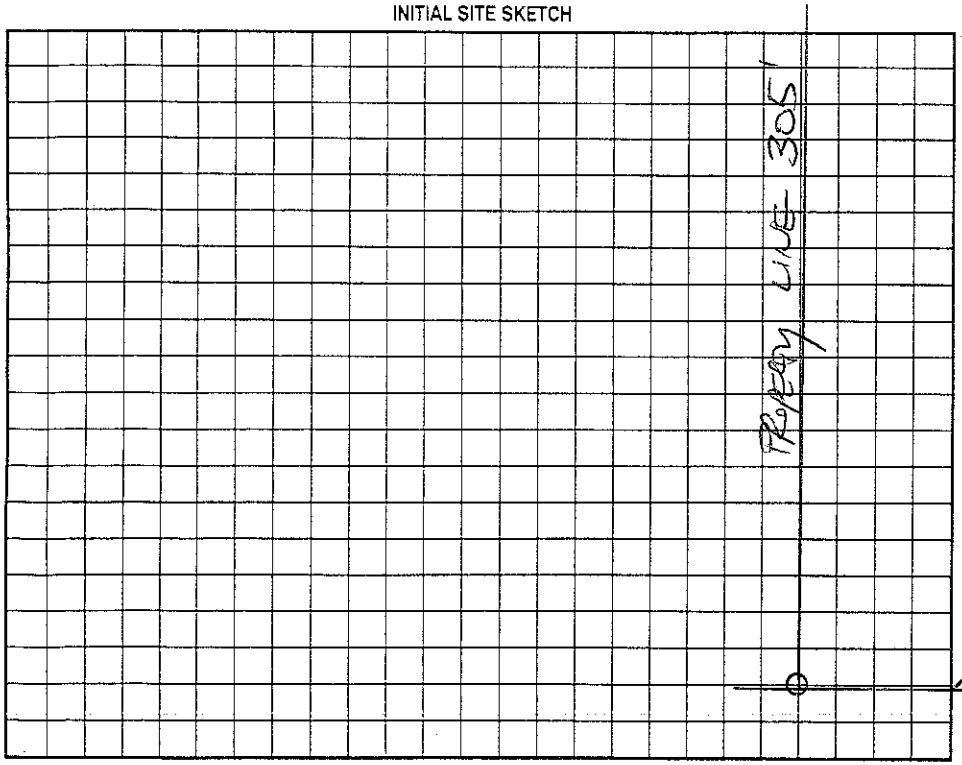

AS BUILT SKETCH

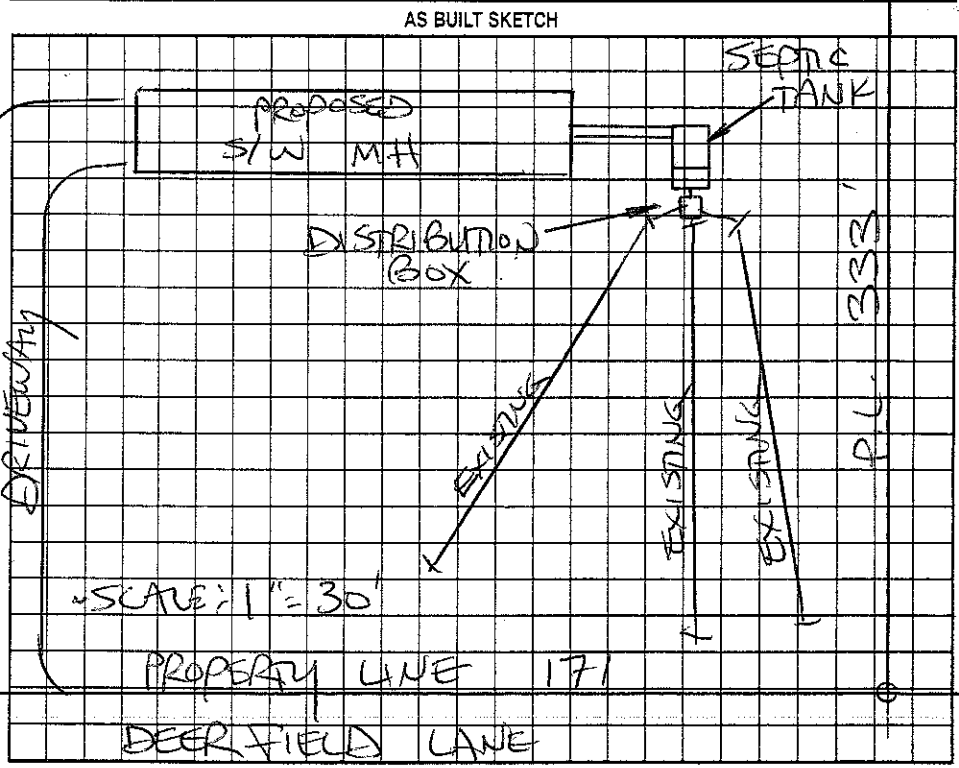

Permit can be suspended or revoked if any false information is supplied toward securing the permit/any unauthorized changes are made to the site/any unauthorized changes are made in the installation of the system. Improvement Permit with plat valid without expiration. Improvement Permit with site plan valid for sixty months. Authorization to Construct is valid for a period equal to that of Improvement Permit -- not to exceed sixty months.

Signed: ____ date ____

Improvement Permit by: ____ date ____

Authorization to Construct by: ____ date ____

Installed by: ____

Operation Permit by: ____ date ____

Existing System Inspection by: STEVE HEDRICK date 5-12-04

HEALTH DEPT. COPY: WHITE OWNER COPY (FINAL): YELLOW OWNER COPY (INITIAL): PINK