IREDELL COUNTY HEALTH DEPARTMENT

PJB

Statesville Office (704) 878-5305 Mooresville Office (704) 660-3625 PERMIT # AP-305216

SEPTIC IMPROVEMENT PERMIT / AUTHORIZATION TO CONSTRUCT / OPERATION PERMIT / EXISTING SYSTEM

PIN # 4723-84-2630 ✓

APPLICANT/OWNER: Foothills Septic Inspection/Freda Styers APPLICANT ADDRESS: 1192 Dudley Shoals Rd. Granite Falls, NC 28630

SITE ADDRESS: ✓149 Chatfield Loop Statesville, NC 28677 PHONE: 828-308-5994 ALT. PHONE

SITE DIRECTIONS: Buffalo Shoals Rd West from Statesville → L on Chatfield Loop → House on left SAP CONTROLLED: ☐ YES ☒ NO

SUBDIVISION: ✓Mary E L Bostian SECTION: — LOT # 112-115 LOT AREA: 0.45 acres DESIGN FLOW: 240 GPD L.T.A.R.: —

Septic Tank	1000	(gal)	STB		Date						
Pump Tank	—	(gal)	PT	—	Date	—					
Pump Make	—	Model		—	Serial #	—					
# Nitrification Fields	1	# Lines	Ex Bed		Linear Ft	Ex					
Trench Width	Ex	Trench Bottom Depth(Low side)		Ex	Gravel Depth	Ex					

☐ New System ☒ Repair ☐ Expansion System Type: I II (III) IV V VI

System Description: Replace septic tank as needed. Check

Repair System Description: Distribution Box + replace if needed.

Maintenance Agreement Required: ☐ YES ☒ NO

☒ GRAVITY ☐ PRESSURE


☒ Residence ☐ Business ☐ Other ☐ Slab ☒ Basement w/plumbing ☐ Crawl Space ☐ Basement w/o plumbing

No. Bedrooms 2 No. Persons 4 No. Employees —


Water Supply: ☐ Private ☒ Public ☐ Community

Comments / Conditions: Old tank to be pumped by licensed septic hauler and crushed in place. Uncover distribution box and replace, if needed. Recommend pumping septic tank every 5 years.

INITIAL SITE SKETCH

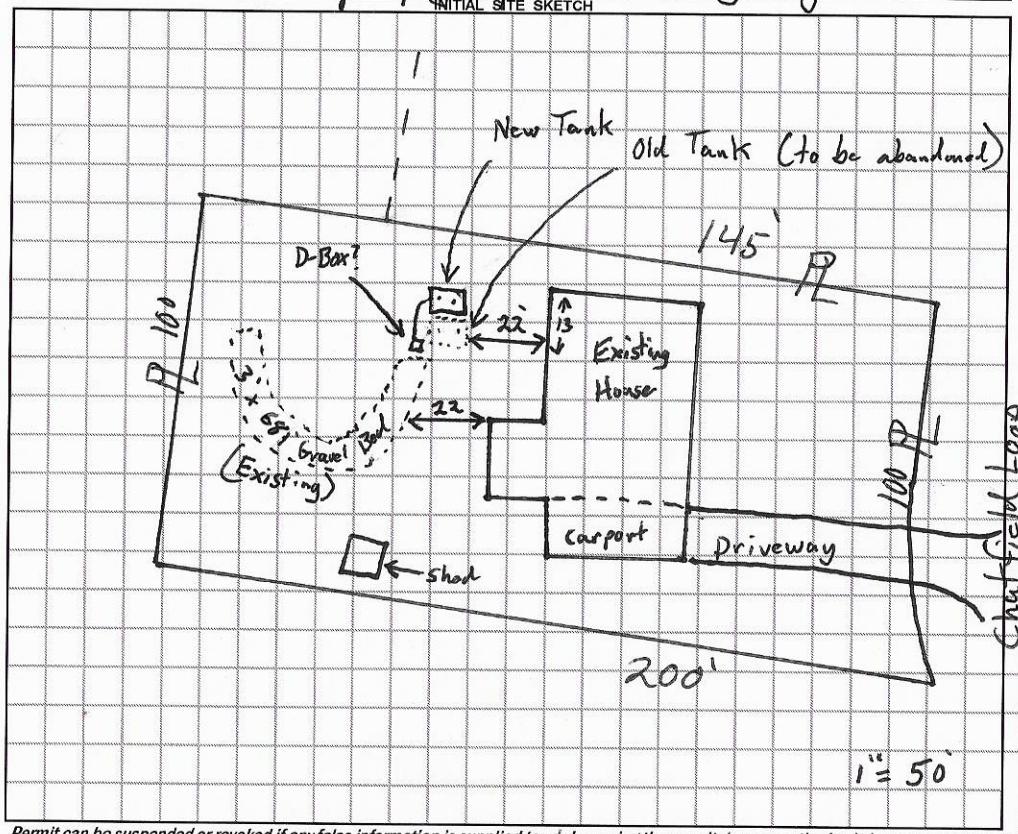

AS BUILT SKETCH

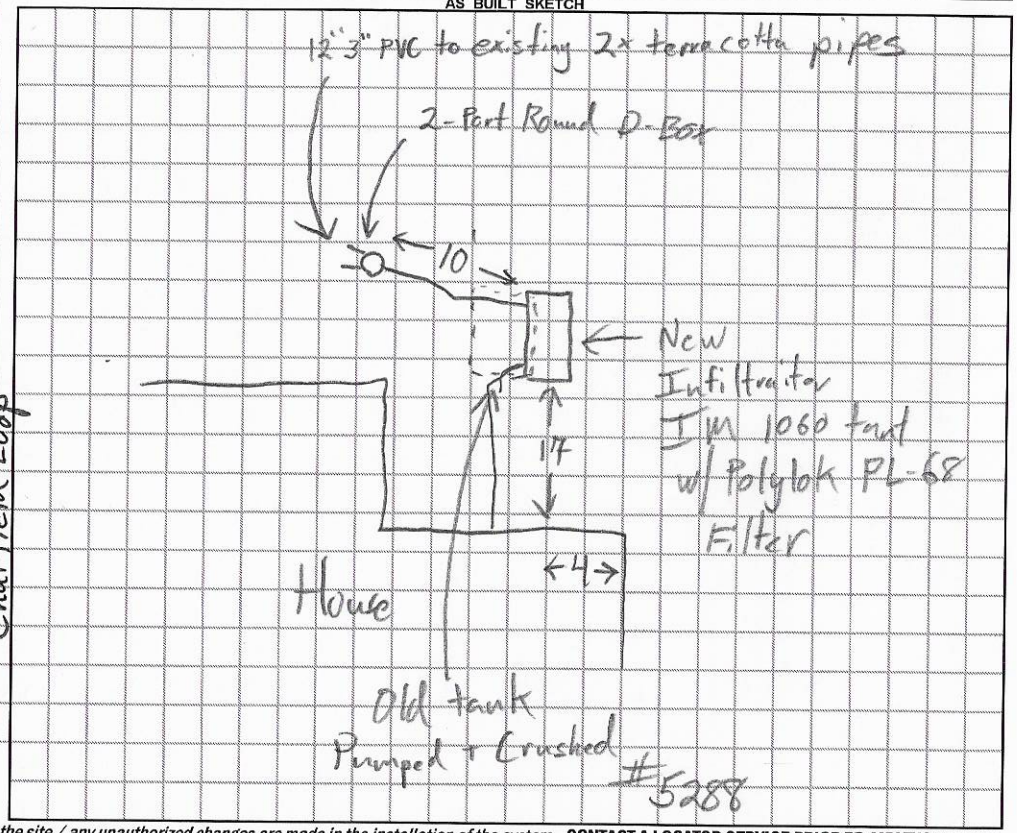

Permit can be suspended or revoked if any false information is supplied toward securing the permit / any unauthorized changes are made to the site / any unauthorized changes are made in the installation of the system. **CONTACT A LOCATOR SERVICE PRIOR TO ANY EXCAVATION**

☐ **IMPROVEMENT PERMIT** *with plat valid without expiration.* ☒ **IMPROVEMENT PERMIT** *with site plan valid for 60 mos.* ☒ **AUTHORIZATION TO CONSTRUCT** *valid for period equal to IMPROVEMENT PERMIT--not to exceed 60 mo.*

Owner / Applicant Signature: Stephanie Styers Date: 2/27/2020 Installed by: Brendan Janyssek Foothills Septic

IMPROVEMENT PERMIT by: Tom Shuck Date: 2/27/2020 OPERATION PERMIT by: Tom Shuck Date: 2/28/2020

AUTHORIZATION TO CONSTRUCT by: Tom Shuck Date: 2/27/2020 Existing System Inspected by: Date:

FOR SEPTIC FINAL INSPECTION: CALL 704-664-3703 between 8am-9am the day the inspection is needed. Be sure to speak with an inpsector to confirm your inspection time.

RECEIVED FEB 2 0 2020 AP-365 216

Iredell County Health Department – Environmental Health Division

PAGE 1: *APPLICATION FORM*

Application For: ( ) New Well Permit ( ) Well Repair Permit ( ) Well Abandonment
( ) Septic Improvement Permit ( ) Authorization to Construct ( ) Existing System Inspection (X) Septic System Repair Tank Replacement only

THE ABOVE PERMIT DOCUMENTS WILL BECOME INVALID IF INFORMATION PROVIDED ON THIS APPLICATION IS FALSIFIED OR CHANGED, OR IF THE SITE IS ALTERED. THE IMPROVEMENT PERMIT IS VALID FOR EITHER 60 MONTHS OR WITHOUT EXPIRATION DEPENDING UPON DOCUMENTATION SUBMITTED. APPLICATION WITH SITE PLAN 60 MONTHS, APPLICATION WITH COMPLETE, SCALED PLAT WITHOUT EXPIRATION. SEE 15A NCAC 18A .1937(f) FOR DETAILS.

Page 2: *Site Plan Worksheet* form MUST accompany this application

The following optional attachments may also be submitted: ( ) Survey Plat, scaled no more than 1 inch = 60 feet
Place an (X) beside whichever is submitted if applicable ( ) Custom Site Plan, scaled no more than 1 inch = 60 feet

Applicant Information: (PRINT CLEARLY)

Applicant Name: Foothills Septic + Inspection Address: 1192 Dudley Shoals Rd Granite Falls Zip: 28630
Applicant Email: foothillsseptic-inspection@gmail.com Phone: 828-308-5914 Alt. Phone: _____
Owner Name: Freda Styers Address: 149 Chatfield Loop Statesville Zip: 28677
Owner Email: _____ Phone: _____ Alt. Phone: _____

Property Information:

Street Address: 149 Chatfield Loop Statesville NC 28677
Subdivision Name: Mary E L Bostian Section/Phase: _____ Lot Number: 112-115
Driving Directions: I-40W - Take exit 148, turn B onto NC90 E/US-64, continue onto Connor Bagnal Blvd. Turn R onto Buffalo Shoals Rd Turn L onto Chatfield Loop

Site Development Information: *(check or complete ALL that apply)*

( ) New Single Family Residence
( ) New Multi-Family Residence
( ) Accessory Building
( ) Bedroom(s) Addition
(X) Repair to failing septic system X Tank ___ Drain lines Describe Problem: Tank structurally failed
Non-Residential Site Development: Type of Business: _____
Square Footage of Building: _____ Max. Number of Employees: _____ Max. Number of Seats/Beds/Other: _____

Maximum Number of Bedrooms: 2 WA 2/21/2020
Maximum Number of Occupants: _____
( ) Swimming Pool
( ) Other Addition/Structure: _____

CHECK FOUNDATION TYPE
( ) Crawl Space Foundation
( ) Concrete Slab Foundation
(X) Basement with Plumbing
( ) Basement without Plumbing

Water Supply: ( ) Replacement Well – Reason: _____
( ) Multi-connection Well Number of Houses: _____ Number of Persons: _____
( ) New Well ( ) Existing Well ( ) Community Well (X) City Water ( ) Other Public Water

Desired Septic System Type: *(you may rank in order of preference)* Year existing system installed: _____
( ) No Preference ( ) Alternative ( ) Conventional ( ) Innovative ( ) Modified Conventional ( ) Other: _____

Please answer the following to the best of your ability:
( ) Yes (X) No Does the site contain any jurisdictional wetlands?
( ) Yes (X) No Is any non-domestic sewage (i.e. industrial) to be generated?
( ) Yes (X) No Is the site subject to approval by any other public agency?

I have read this application and certify that the information provided herein is true, complete, and correct. Authorized county and state officials are granted right of entry to conduct necessary inspections to determine compliance with applicable laws and rules. I understand that I am solely responsible for the proper identification and labeling of all property lines and corners and making the site accessible so that a complete site evaluation can be performed.

Signature: _____
Property owner or owner's legal representative signature ~~(SIGNATURE REQUIRED)~~

2/20/2020
DATE

RECEIVED FEB 2 0 2020 AP-305216

APPLICATION MUST BE FILLED OUT COMPLETELY & BE LEGIBLE
OR IT WILL NOT BE PROCESSED

Iredell County Health Department – Environmental Health Division

PAGE 1: *APPLICATION FORM*

Application For: ( ) New Well Permit ( ) Well Repair Permit ( ) Well Abandonment
( ) Septic Improvement Permit ( ) Authorization to Construct ( ) Existing System Inspection (✓) Septic System Repair Tank Replacement only

THE ABOVE PERMIT DOCUMENTS WILL BECOME INVALID IF INFORMATION PROVIDED ON THIS APPLICATION IS FALSIFIED OR CHANGED, OR IF THE SITE IS ALTERED. THE IMPROVEMENT PERMIT IS VALID FOR EITHER 60 MONTHS OR WITHOUT EXPIRATION DEPENDING UPON DOCUMENTATION SUBMITTED. APPLICATION WITH SITE PLAN 60 MONTHS, APPLICATION WITH COMPLETE, SCALED PLAT WITHOUT EXPIRATION. SEE 15A NCAC 18A .1937(f) FOR DETAILS.

Page 2: *Site Plan Worksheet* form MUST accompany this application

The following optional attachments may also be submitted: ( ) Survey Plat, scaled no more than 1 inch = 60 feet
Place an (X) beside whichever is submitted if applicable ( ) Custom Site Plan, scaled no more than 1 inch = 60 feet

Applicant Information: (PRINT CLEARLY)

Applicant Name: Foothills Septic & Inspection **Address:** 1192 Dudley Shoals Rd Granite Falls **Zip:** 28630

Applicant Email: foothillsseptic inspection@gmail.com **Phone:** 828-302-5914 **Alt. Phone:** _____

Owner Name: Freda Styers **Address:** 149 Chatfield Loop Statesville **Zip:** 28677

Owner Email: _____ **Phone:** _____ **Alt. Phone:** _____

Property Information:

Street Address: 149 Chatfield Loop Statesville NC 28677 replaced

Subdivision Name: Mary E L Bostian **Section/Phase:** _____ **Lot Number:** 112-115

Driving Directions: I-40W - Take exit 148, turn R onto NC90 E/US-64, continue onto Garner Bagnal Blvd. Turn R onto Buffalo Shoals Rd Turn L onto Chatfield Loop

Site Development Information: *(check or complete ALL that apply*

CHECK FOUNDATION TYPE

( ) New Single Family Residence
( ) New Multi-Family Residence
( ) Accessory Building
( ) Bedroom(s) Addition
(X) Repair to failing septic system X Tank ___ Drain lines **Describe Problem:** Tank structurally failed

Maximum Number of Bedrooms: _____
Maximum Number of Occupants: _____
( ) Swimming Pool
( ) Other Addition/Structure: _____

( ) Crawl Space Foundation
( ) Concrete Slab Foundation
(X) Basement with Plumbing
( ) Basement without Plumbing

Non-Residential Site Development: **Type of Business:** _____
Square Footage of Building: _____ **Max. Number of Employees:** _____ **Max. Number of Seats/Beds/Other:** _____

Water Supply: ( ) Replacement Well – Reason: _____
( ) Multi-connection Well **Number of Houses:** _____ **Number of Persons:** _____

( ) New Well ( ) Existing Well ( ) Community Well (X) City Water ( ) Other Public Water

Desired Septic System Type: *(you may rank in order of preference)* **Year existing system installed:** _____
( ) No Preference ( ) Alternative ( ) Conventional ( ) Innovative ( ) Modified Conventional ( ) Other: _____

Please answer the following to the best of your ability:

( ) Yes (X) No **Does the site contain any jurisdictional wetlands?**
( ) Yes (X) No **Is any non-domestic sewage (i.e. industrial) to be generated?**
( ) Yes (X) No **Is the site subject to approval by any other public agency?**

I have read this application and certify that the information provided herein is true, complete, and correct. Authorized county and state officials are granted right of entry to conduct necessary inspections to determine compliance with applicable laws and rules. I understand that I am solely responsible for the proper identification and labeling of all property lines and corners and making the site accessible so that a complete site evaluation can be performed.


Signature: _____ 2/20/2020
Property owner or owner's legal representative signature ~~(SIGNATURE REQUIRED)~~ DATE

IREDELL COUNTY HEALTH DEPARTMENT

ENVIRONMENTAL HEALTH DIVISION

PAGE 2: *SITE PLAN WORKSHEET*

SEE THE "SAMPLE SITE PLAN" BELOW. *INCOMPLETE SITE PLANS WILL BE RETURNED TO YOU FOR COMPLETION AND MAY RESULT IN A DELAY IN THE ISSUANCE OF YOUR SEPTIC SYSTEM PERMIT!!!*

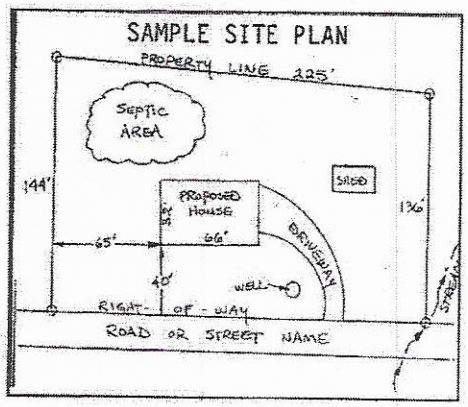

Place an (X) beside each item as you complete the site plan:


( ) Property Line measurements are clearly identified
( ) All proposed structures are indicated
( ) Front and side setbacks from property line
( ) Preferred driveway location and well location
( ) Area you prefer your septic system to be placed
( ) North arrow, or other sufficient indicator of direction

Circle N/A on the following if appropriate:

Location of septic systems and wells within 100' of your property	N/A
Location of easements and rights of ways on your property	N/A
Location of any designated wetlands on the property	N/A

USE THIS SPACE TO DRAW YOUR SITE PLAN

Show: proposed house or business footprint, wells, water lines, patios, pools and decks, and any other item that will occupy space on the site

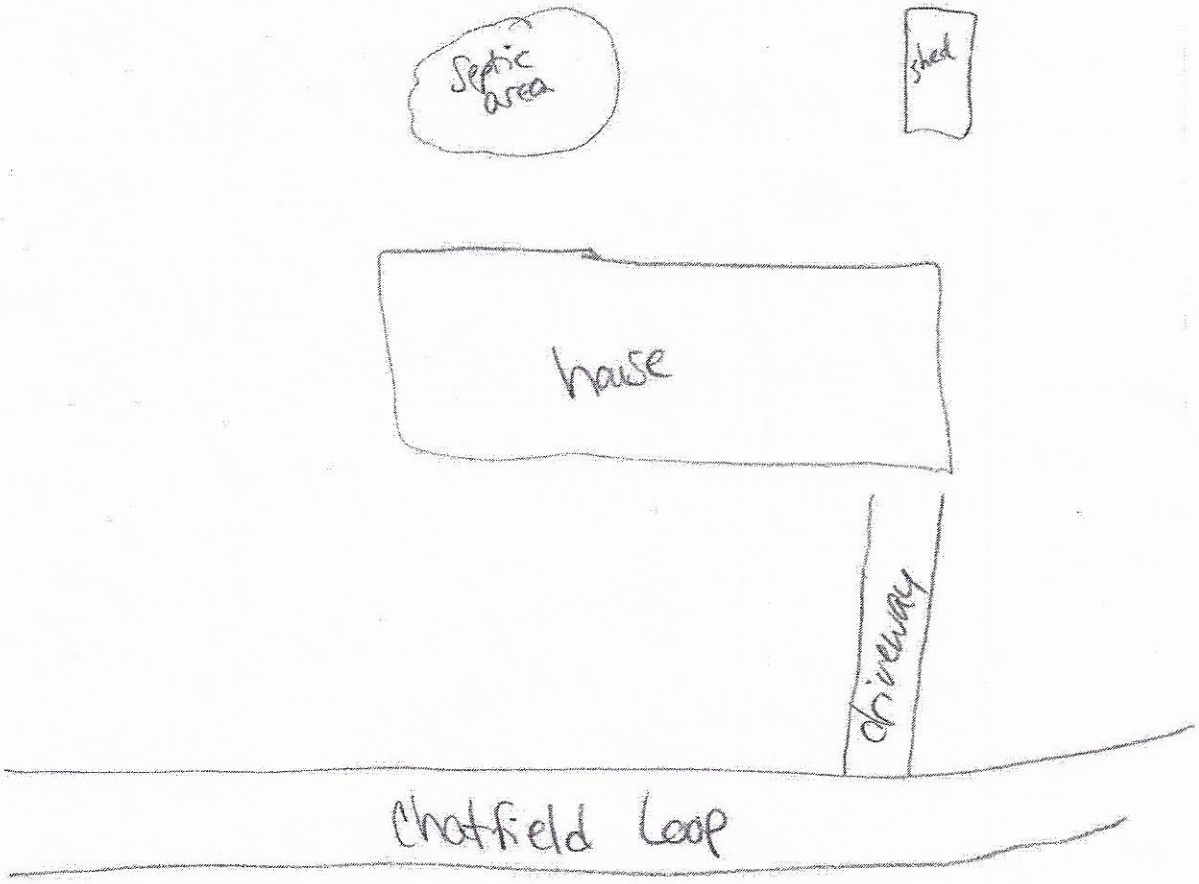

Signature: _____

Property owner or owner's legal representative signature (SIGNATURE REQUIRED) _____ **DATE**

Public Health

IREDELL COUNTY DEPARTMENT OF ENVIRONMENTAL HEALTH

Public Health

DOCUMENTATION TO AUTHORIZE AN OWNER'S LEGAL REPRESENTATIVE

(Check and sign only ONE of the options below)

1. *** APPLICANT AND OWNER ARE THE SAME. *** *(Sign here)* _____

Applications for permits require the "signature of the owner or owner's legal representative" (15A NCAC 18A .1937). If the owner does not sign the application himself or herself, they can submit any one of the following documents to designate their legal representative: *Power of Attorney; Real Estate Contract; Estate executor; Bankruptcy trustee; Court ordered guardianship* In the absence of the above documentation, the property owner may provide the local health department with documentation that designates a legal representative. A property owner may:
Complete this form to document his or her legal representative, or provide his or her own form that contains the information in this form. If there are multiple property owners, then all property owners must sign the form that designates a legal representative.
By signing a form that designates a legal representative for purposes of 15A NCAC 18A .1937, the property owner authorizes that representative to act on their behalf in matters pertaining to the application and permitting process, including signing or receiving any application, document or permit. The owner retains full responsibility to meet all permit conditions specified by the local health department.

✓ 2. I, FREDA STYERS, am the legal owner(s) of the property located at 149 CHATFIELD LOOP STATESVILLE NC, identified as PIN (Parcel Identification Number) 4733-84-2630.000, located in Iredell County, North Carolina.

I do hereby authorize (**print legal representative/company name**) BRANDON JANYSSEK, @ FOOTHILLS SEPTIC, to act as an agent on my behalf in applying for/signing/obtaining any of the documents described below.

- Application for Improvement Permit (IP) / Authorization to Construct (AC)
- Improvement Permit (IP) / Authorization to Construct (AC)
- Application for soil-site evaluation (new/repair)
- Application/permit for private drinking water well/well abandonment
- Application for Compliance Inspection

I agree to abide by all decisions and/or conditions between the legal representative acting on my behalf and the Iredell County Department of Public Health, Environmental Health Division.

Freda Styers
Signature of Owner(s)

2/18/20
Date

Mooresville - Environmental Health

Fax: 704-662-3239
610 E. Center Avenue, Mooresville, NC 28115

Statesville - Environmental Health

Fax: 704-871-3483
349 N. Center Street, Statesville, NC 28677