IREDELL COUNTY HEALTH DEPARTMENT

Statesville Phone TR 3-7271 Mooresville Phone NO 3-1271

PERMIT TO INSTALL SEPTIC TANK

Permit NO. Ft Mc/Jumbia Bldr Permit Date May 22 19 65

Owner Wade Watt Address Boston Hgts.

Installed By C Hoke Address


Location of Property RT - out Buffalo Shoals Rd. Cross RR & Creek 3rd rd to left. on Corner 1 block in

Tank		Capacity		Length of Lines		Fixtures	
Block	(✓)	800	( )	150'	( )	No. of Baths	(2½)
Precast	(✓)	900	( )	175'	( )	Dishwasher	( )
		1000	( )	200'	( )	Garbage Grdr.	(✓)
		1100	( )	225'	( )	Auto-Washer	(✓)
		1200	( )	250'	( )	Other	
		Other 1250		Other 255' 127½ long 5' wide			

NOTIFY HEALTH DEPARTMENT AT LEAST EIGHT HOURS BEFORE TANK IS TO BE INSPECTED.

Final Inspection _____ 19___ Approved ( ) Disapproved ( )

Remarks well 60'

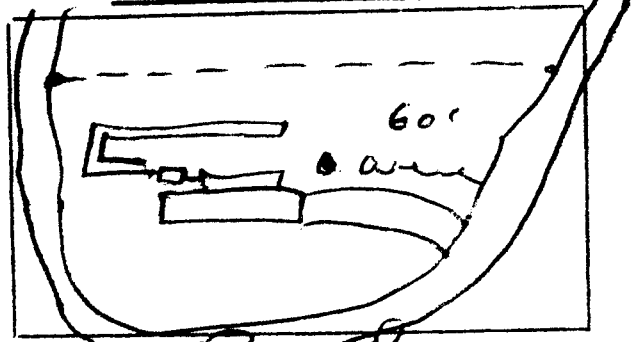

Sketch of Installation

Sanitarian