IREDELL COUNTY HEALTH DEPARTMENT - *ENVIRONMENTAL HEALTH* ☐ STATESVILLE OFFICE 704-878-5305 ☐ MOORESVILLE OFFICE 704-664-5281

IMPROVEMENT PERMIT / AUTHORIZATION TO CONSTRUCT / OPERATION PERMIT / EXISTING SYSTEM INSPECTION

PERMIT # R-pair PIN # 4723-85-2163 DATE 2 May 2011

OWNER Pat Tighe APPLICANT: PHONE: Home/Cell # (704) 929-9282 Business #

SITE ADDRESS 129 Chatfield Lp. Stvl. OWNER / APPLICANT ADDRESS

SITE DIRECTIONS Buffalo Shoals Rd. TL Chatfield Lp. 5th House on Left.

SUBDIVISION BLOCK / SECTION LOT # LOT AREA 0.38Ac. DESIGN FLOW 360 gpd L.T.A.R. 0.3 gal/ft²d

Septic Tank Exist. Gallons: STB Date

Pump Tank Gallons: P T Date

Pump Make Model Serial #

No. Nitrification Fields: 1 No. Lines 16 Linear Feet 150'-300

Trench Width 24"-36" Max. Trench Bottom Depth 36" Gravel Depth NA

☐ New System ☑ Repair ☐ Expansion System Type I II (III) IV V VI

System Description: 25%

Repair System Description: ~~50%~~ Reduction system.

Maintenance Agreement Required ☐ YES ☑ NO

☑ GRAVITY ☐ PRESSURE


☑ Residence ☐ Business ☐ Other ☐ Slab ☐ Crawl Space ☑ Basement w/plumbing ☐ Basement w/o plumbing

No. Bedrooms 3 No. Persons No. Employees

Water Supply: ☑ Private ☐ Public ☐ Community

Comments / Conditions: Install 34 panels of PP13PS (DJ) for repair of existing system. * Keep 10' from existing water line.

INITIAL SITE SKETCH

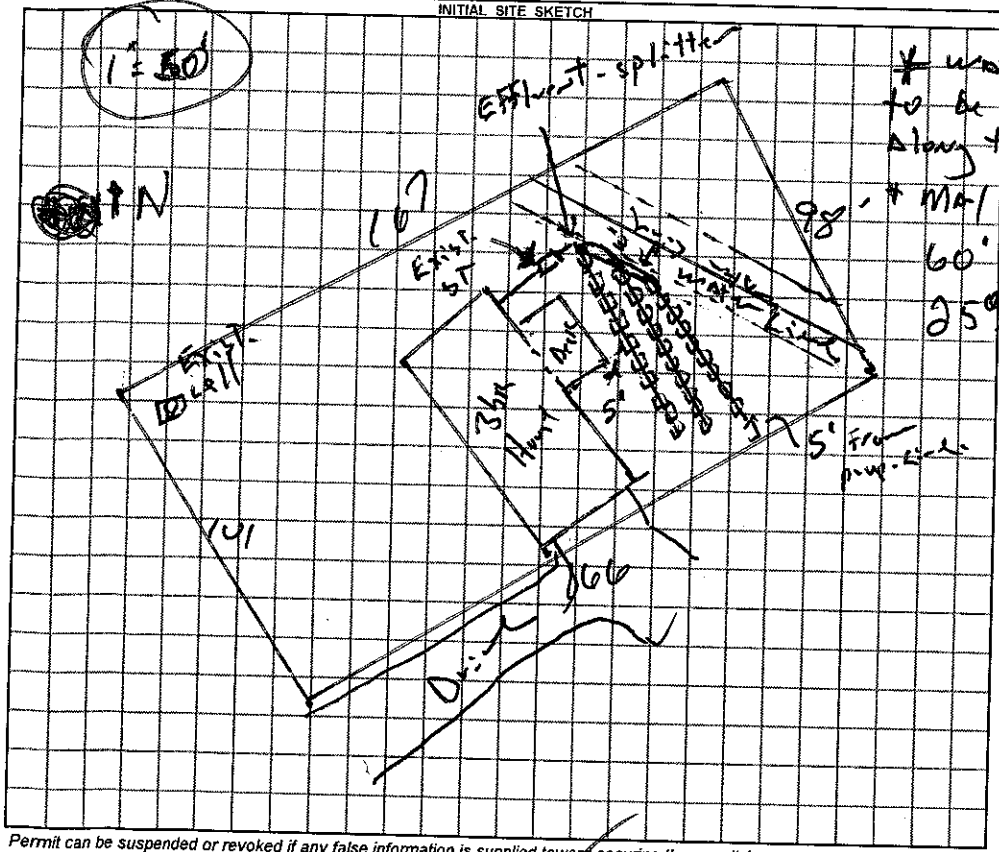

AS BUILT SKETCH

* water line to be rerouted along the property line. * Must install AS Stms 60' in length of 25% Reduction System.

Permit can be suspended or revoked if any false information is supplied toward securing the permit / any unauthorized changes are made to the site / any unauthorized changes are made in the installation of the system.

☐ ***IMPROVEMENT PERMIT*** with plat valid without expiration. ☑ ***IMPROVEMENT PERMIT*** with plat valid without expiration. site plan valid 60 mo. ☑ ***AUTHORIZATION TO CONSTRUCT*** valid for period equal to IMPROVEMENT PERMIT--not to exceed 60 mo.

Owner / Applicant Signature: Date 5/3/11 Installed by: A-1 Backhoe

IMPROVEMENT PERMIT by: REHS Date 2 May 2011 OPERATION PERMIT by: REHS Date 6-8-11

AUTHORIZATION TO CONSTRUCT by: REHS Date 2 May 2011 Existing System Inspected by: REHS Date

YOU SHOULD CONTACT A LOCATOR SERVICE PRIOR TO ANY EXCAVATION

White Copy – Environmental Health YELLOW COPY (Final) Owner / Applicant PINK COPY (Initial) Owner / Applicant