IREDELL COUNTY HEALTH DEPARTMENT

STATESVILLE 704-878-5305 MOORESVILLE 704-664-5281

IMPROVEMENT PERMIT / CERTIFICATE OF COMPLETION / OPERATION PERMIT / EXISTING SYSTEM INSPECTION

PROPERTY DESCRIPTION NO. 23825 DATE 5-24-96 TAX MAP NO. 6E15 + 6E44D Watershed: ☐ Yes ☒ No

OWNER OR CONTRACTOR Chris Davidson PHONE: Business Home 528-6192

ADDRESS PO Box 5602 Statesville

LOCATION Buffalo Shoals Rd before Airport Rd on left

SUBDIVISION Ravenwood BLOCK / SECTION LOT 4 LOT AREA 1.93 acres SITE CLASS. PS DESIGN FLOW 240 L.T.A.R.

Septic Tank: 1000 Gallons; STB 794 Date 4-8-96

Pump Tank: Gallons; PT Date

Pump Make: Model Serial No.

Nitrification Field: No Fields 1 Square Feet 612 Linear Feet 204

No Lines 2 Trench Width 36" Max Trench Bottom Depth 36" Gravel Depth N/A

☒ New System ☐ Repair System Type: I. II. III. IV. V. VI

System Description: Gravity Chambers

Repair System Description: " "

Maintenance Agreement Required: ☐ Yes ☒ No

☒ House/Mod. Home No. Bedrooms 3

☐ Mobile Home No. Bathrooms 2

☐ Business No. Employees

☐ Other


☐ Slab ☒ Crawl Space ☐ Basement w/plumbing ☐ Basement wo/plumbing

Water Supply: ☒ Individual ☐ Community ☐ Public


Comments:

Comments: Add 100' To bring up To 3 bedroom size Had Enough Repair for 3 bedroom system using Chambers

INITIAL SITE SKETCH

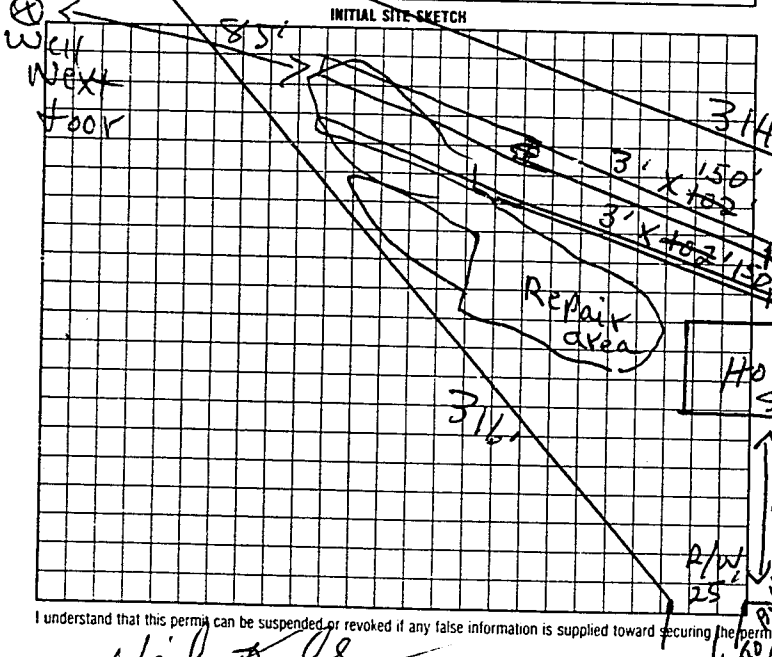

AS BUILT SKETCH

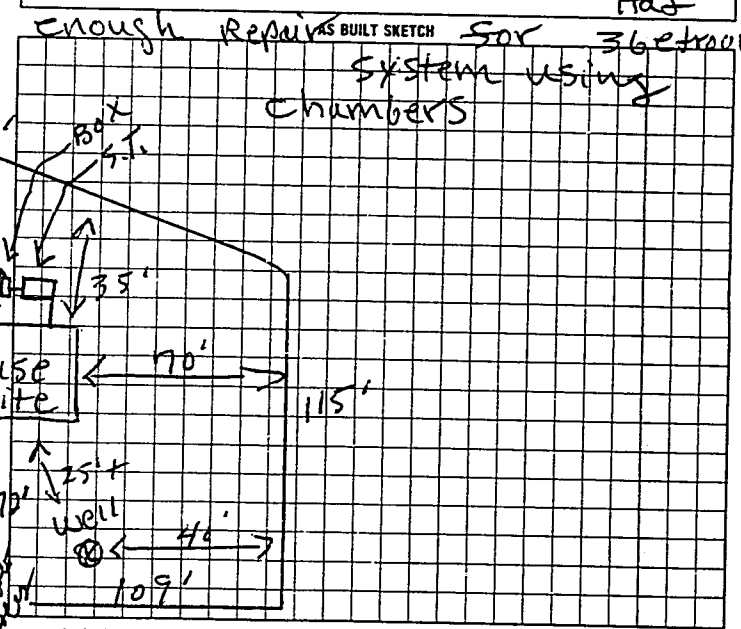

I understand that this permit can be suspended or revoked if any false information is supplied toward securing the permit, any unauthorized changes are made to the site/any unauthorized changes are made in the installation of the system.

Signed: Neil Hall

Improvement Permit by: R.C. Moore date 5-24-96

Existing System Inspection by: authorization R.C. Moore date 5-24-96

to connect

Installed by: Chris Davidson

Certificate of Completion by: date

Operation Permit by: R.C. Moore date 7-25-96

authorization to connect. Expires 60 mos from issue

HEALTH DEPT. COPY WHITE INSPECTION COPY (FINAL) GREEN OWNER COPY (FINAL) YELLOW INSPECTION COPY (INITIAL) PINK OWNER COPY (INITIAL) GOLD