IREDELL COUNTY HEALTH DEPARTMENT

STATESVILLE 704-878-5305 MOORESVILLE 704-664-5281 57682

IMPROVEMENT PERMIT / CERTIFICATE OF COMPLETION / OPERATION PERMIT / EXISTING SYSTEM INSPECTION

PROPERTY DESCRIPTION NO. 22053 DATE 9-5-95 TAX MAP NO. 6E-15-A-5 Watershed: ☐ Yes ☒ No

OWNER OR CONTRACTOR CRIS DAVIDSON PHONE: Business 528-6192 Home

ADDRESS P.O. BOX 5602 STATESVILLE, NC 28677

LOCATION BUFFALO SHOALS RD, ON LEFT JUST BEFORE AIRPORT RD.

SUBDIVISION RAVEN WOOD BLOCK / SECTION LOT 5 LOT AREA SITE CLASS. DESIGN FLOW L.T.A.R. .3

Septic Tank: 1000 Gallons; STB 1794 Date 8-16-95 ☒ New System ☐ Repair System Type: I, II, III, IV, V, VI

Pump Tank: Gallons; PT Date System Description: CONV. GRAVITY

Pump Make: Model Serial No. Repair System Description: CONV. PUMP PRESS

Nitrification Field: No Fields 1 Square Feet 875 Linear Feet 385 Maintenance Agreement Required: ☐ Yes ☒ No

No Lines 4 Trench Width 3 Max Trench Bottom Depth 36" Gravel Depth 12" ☐ Slab ☒ Crawl Space ☐ Basement w/plumbing ☐ Basement wo/plumbing

☒ House/Mod. Home No. Bedrooms 2

☐ Mobile Home No. Bathrooms 2

☐ Business No. Employees


☐ Other

Water Supply: ☒ Individual ☐ Community ☐ Public


Comments: KEEP BOTTOM OF TRENCHES NO DEEPER THAN 36" KEEP SYSTEM 10' FROM PROPERTY LINES, 5' FROM FOUNDATION OF HOME, KEEP WELL AT LEAST 50' FROM REPAIR AREA

Comments: well not on site at Time of this inspection

INITIAL SITE SKETCH 125'

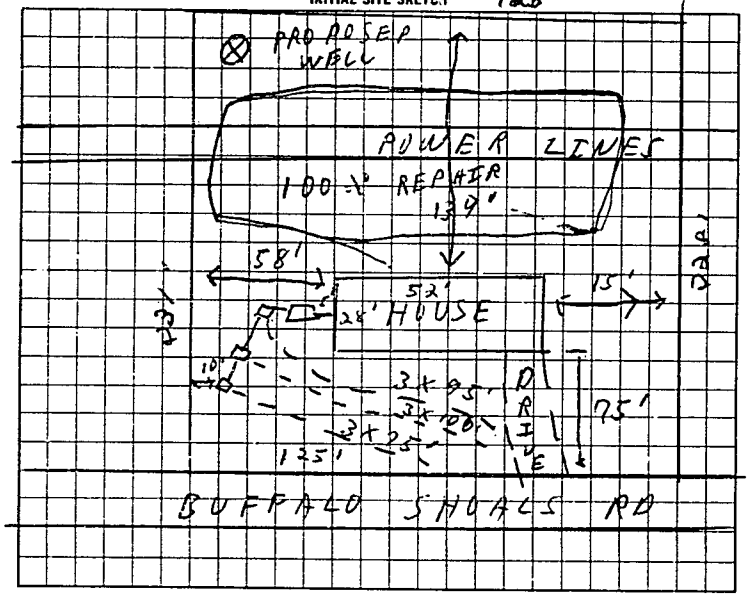

AS BUILT SKETCH 125'

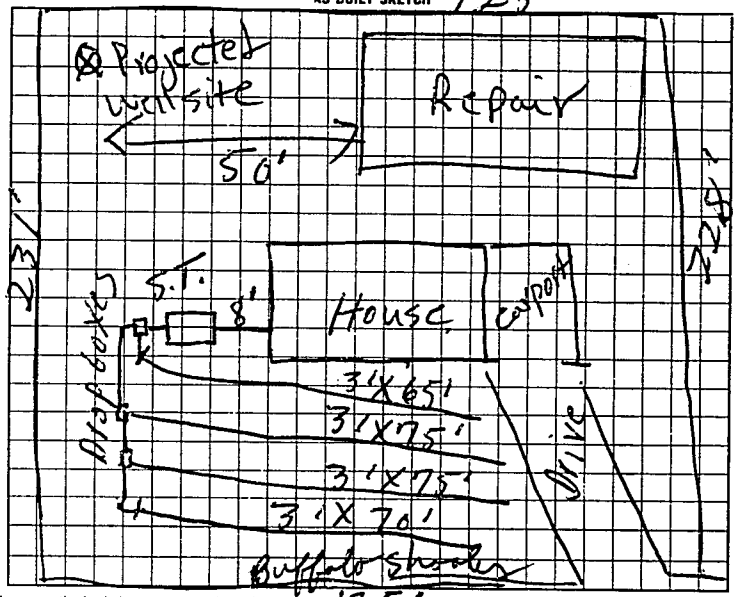

I understand that this permit can be suspended or revoked if any false information is supplied toward securing the permit/any unauthorized changes are made to the site/any unauthorized changes are made in the installation of the system.

Signed: [signature]

Improvement Permit by: J.C. Moore date 9-5-95

Existing System Inspection by date

Installed by: Robert Hoke

Certificate of Completion by: ~~J.C. Moore~~ date ~~11-20-95~~

Operation Permit by J.C. Moore date 11-20-95

HEALTH DEPT. COPY: WHITE INSPECTION COPY (FINAL): GREEN OWNER COPY (FINAL): YELLOW INSPECTION COPY (INITIAL): PINK OWNER COPY (INITIAL): GOLD