D + D Company

58600

IREDELL COUNTY HEALTH DEPARTMENT

STATESVILLE 704-878-5305 MOORESVILLE 704-664-5281

IMPROVEMENT PERMIT / CERTIFICATE OF COMPLETION / OPERATION PERMIT / EXISTING SYSTEM INSPECTION

PROPERTY DESCRIPTION NO. 22457 DATE 11-17-95 TAX MAP NO. 6E-15-A-7 Watershed: ☐ Yes ☐ No

OWNER OR CONTRACTOR Chris Davidson PHONE: Business 528-6192 Home

ADDRESS PO Box 5602 Sta

LOCATION Buffalo Shoals Rd on left before Airport Rd

SUBDIVISION Ravenwood BLOCK / SECTION I LOT 7 LOT AREA 1 acre SITE CLASS. PS DESIGN FLOW 240 L.T.A.R. 1.3

Septic Tank: 1000 Gallons; STB 794 Date 10-3-95

Pump Tank: Gallons; PT Date

Pump Make: Model Serial No.

Nitrification Field: No Fields 1 Square Feet 810 Linear Feet 270

No Lines 3 Trench Width 36" Max Trench Bottom Depth 36" Gravel Depth 12"

☑ New System ☐ Repair System Type: I (II) III, IV, V, VI

System Description: Conv. Gravity

Repair System Description: " "

Maintenance Agreement Required: ☐ Yes ☑ No

☑ House/Mod. Home No. Bedrooms 2

☐ Mobile Home No. Bathrooms 2

☐ Business No. Employees


☐ Other

☐ Slab ☑ Crawl Space ☐ Basement w/plumbing ☐ Basement wo/plumbing

Water Supply: ☑ Individual ☐ Community ☐ Public

Comments:

INITIAL SITE SKETCH

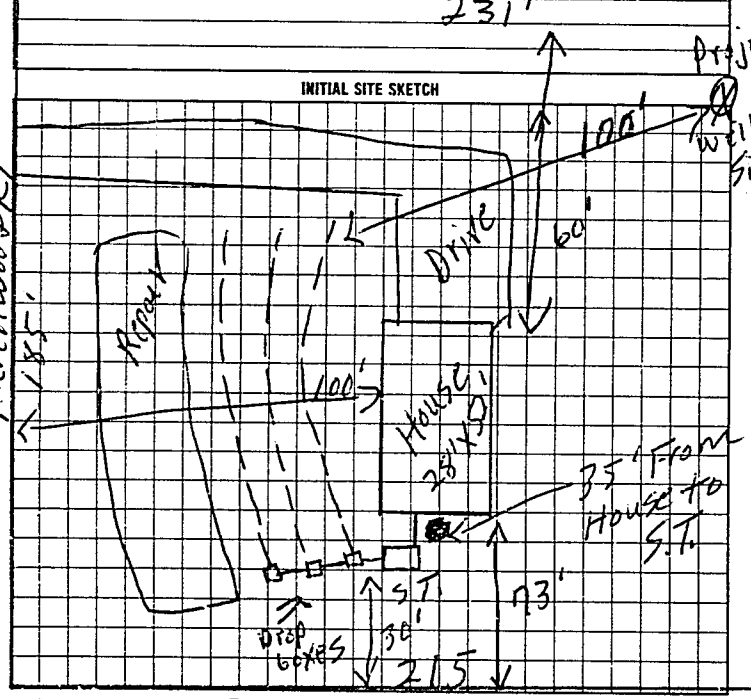


Comments:

AS BUILT SKETCH

Well NOT located at Time of this Inspection

Keep at least 100' From S.T. System

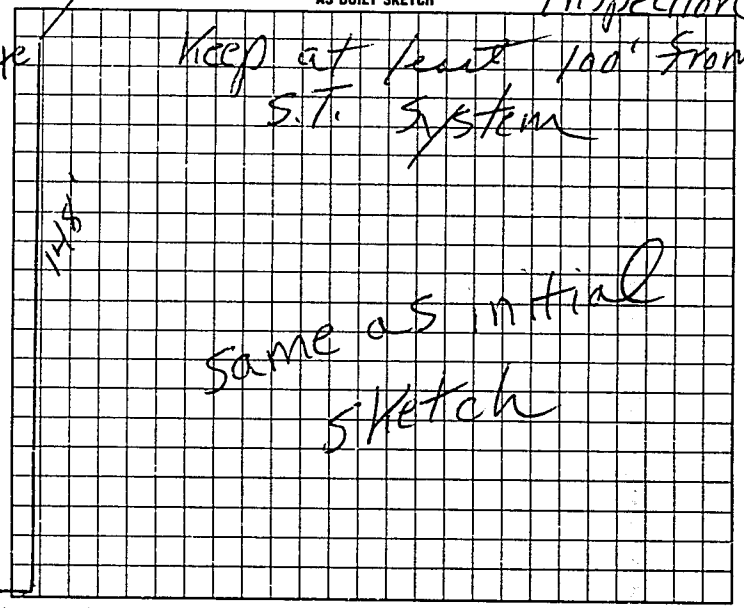

I understand that this permit can be suspended or revoked if any false information is supplied toward securing the permit/any unauthorized changes are made to the site/any unauthorized changes are made in the installation of the system.

Signed D+A Company

Installed by: Robert Hoke

Improvement Permit by: L. C. Moore date 11-17-95

Authorization to Construct by L. C. Moore date 11-17-95

Certificate of Completion by: date

Operation Permit by L. C. Moore date 12-17-95

to Construct DEPT. COPY: WHITE INSPECTION COPY (FINAL): GREEN OWNER COPY (FINAL): YELLOW INSPECTION COPY (INITIAL): PINK OWNER COPY (INITIAL): GOLD

Authorization to Const Expires 6 mos from date of issue

S E P T I C