IREDELL COUNTY HEALTH DEPARTMENT

STATESVILLE 704-878-5305 MOORESVILLE 704-664-5281

IMPROVEMENT PERMIT / AUTHORIZATION TO CONSTRUCT / OPERATION PERMIT / EXISTING SYSTEM INSPECTION

PERMIT# 13176 PIN# 4723941610484 DATE 10-14-05

OWNER OR CONTRACTOR First Choice PHONE: Business 704-883-8228 Home

ADDRESS 119 Beechnut Lane Statesville 28677

LOCATION I-40 W Old NN RD (R) Buffalo Shoals (R) Creg property on right

SUBDIVISION BLOCK / SECTION LOT LOT AREA 1.5 SITE CLASS RS DESIGN FLOW 360 L.T.A.R. 13

Septic Tank: 1000 Gallons; STB 1612 Date 4-05

Pump Tank: Gallons; PT Date

Pump Make: Model Serial No.

Nitrification Field: No Fields Square Feet 1200 Linear Feet 200

No Lines 4 Trench Width 36" Max Trench Bottom Depth 36" Gravel Depth

☐ New System ☐ Repair System Type: I (II, III, IV, V, VI)

System Description: 25 Reduction Gravity

Repair System Description: LPP

Maintenance Agreement Required: ☐ Yes ☐ No Keyser

☐ House/Mod. Home No. Bedrooms 3

☐ Mobile Home No. Bathrooms

☐ Business No. Employees

☐ Other

☐ Slab ☐ Crawl Space ☐ Basement w/plumbing ☐ Basement wo/plumbing

Water Supply: ☐ Individual ☐ Public ☐ Community


Comments:/Conditions:

Install on Contour
Maintain on set backs


Comments:/Conditions: Yellow - Septic tank fill line

*Not to scale

INITIAL SITE SKETCH

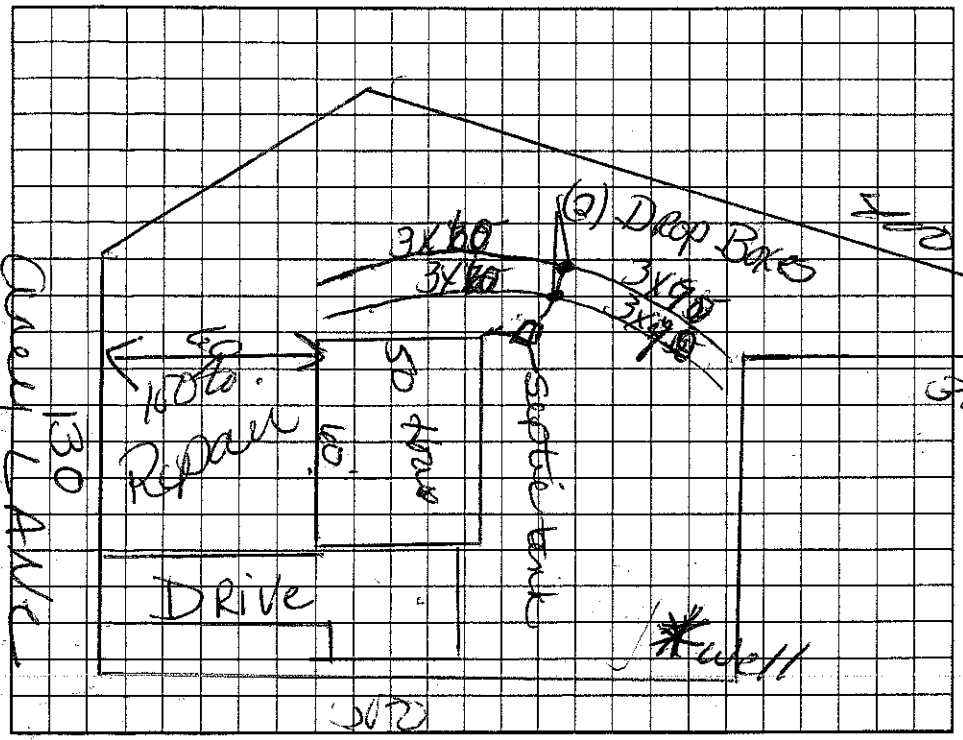

AS BUILT SKETCH

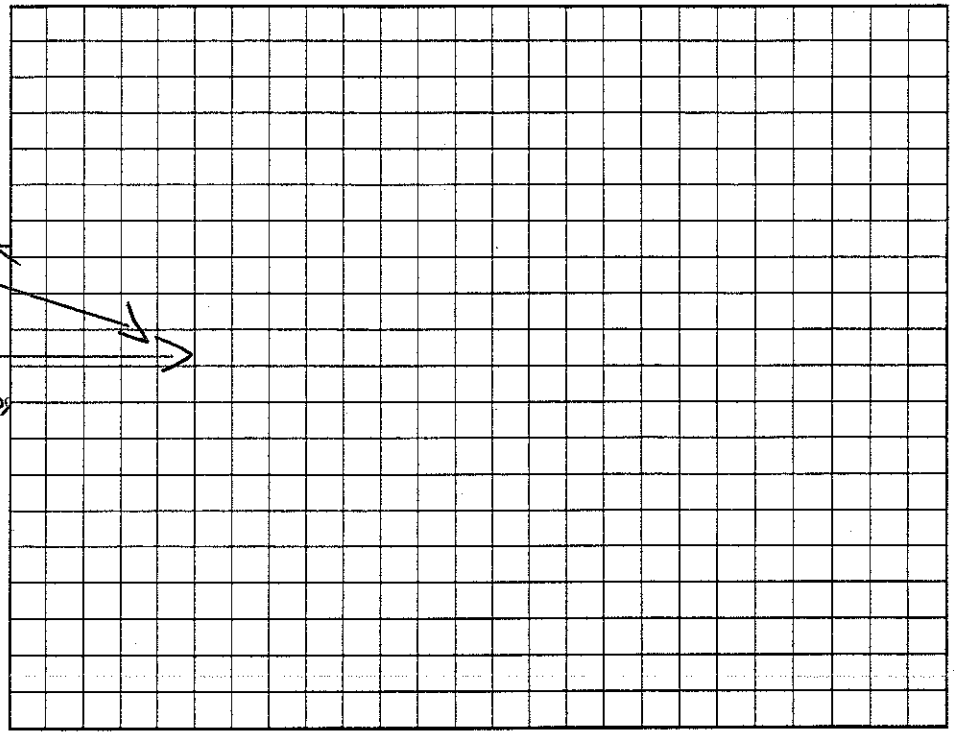

Permit can be suspended or revoked if any false information is supplied toward securing the permit/any unauthorized changes are made to the site/any unauthorized changes are made in the installation of the system. Improvement Permit with plat valid without expiration. Improvement Permit with site plan valid for sixty months. Authorization to Construct is valid for a period equal to that of Improvement Permit – not to exceed sixty months.

Signed: Roger Kirkpatrick date Installed by: A1 Backhoe

Improvement Permit by: Kelly Cook date 10-14-05 Operation Permit by: Kelly Cook date 12-20-05

Authorization to Construct by: Kelly Cook date 10-14-05 Existing System Inspection by: date

HEALTH DEPT. COPY: WHITE OWNER COPY (FINAL): YELLOW OWNER COPY (INITIAL): PINK