IREDELL COUNTY HEALTH DEPARTMENT

STATESVILLE 704-878-5305 MOORESVILLE 704-664-5281

IMPROVEMENT PERMIT / AUTHORIZATION TO CONSTRUCT / OPERATION PERMIT / EXISTING SYSTEM INSPECTION

PERMIT# 095239 PIN# 4723 95 2718 DATE 3/26/01

OWNER OR CONTRACTOR JENKINS AND WILLIAMS PHONE: Business (704) 872-0922 Home

ADDRESS P.O. Box 5277, STATESVILLE, NC 28687

LOCATION BUFFALO SHOALS RD (L) AERY RD. 1000' ON (L)

SUBDIVISION BLOCK / SECTION LOT LOT AREA .88Ac SITE CLASS PS DESIGN FLOW 360 GPD L.T.A.R. .35

Septic Tank: 1000 Gallons: STB 1012 Date 8/19/01
Pump Tank: Gallons; PT Date
Pump Make: Model Serial No.
Nitrification Field: No Fields 1 Square Feet 1023 Linear Feet 345'
No Lines 3 Trench Width 3' Max Trench Bottom Depth 30" Gravel Depth 12"

☒ New System ☐ Repair System Type: I (II) III IV V VI
System Description: CONVENTIONAL
Repair System Description: CONVENTIONAL
Maintenance Agreement Required: ☐ Yes ☒ No


☒ House/Mod. Home No. Bedrooms 3
☐ Mobile Home No. Bathrooms 2
☐ Business No. Employees
☐ Other
☐ Slab ☒ Crawl Space ☐ Basement w/plumbing ☐ Basement wo/plumbing

Water Supply: ☒ Individual ☐ Public ☐ Community


Comments/Conditions: (1) NO CUTTING OR FILLING OVER DRAINFIELD/REPAIR AREAS (2) KEEP ALL DRAINS AWAY FROM DRAINFIELD/REPAIR AREAS (3) MAINTAIN NOTED SETBACKS (4) INSTALL DRAINLINES UNIFORM AND ON CONTOUR

Comments/Conditions: (1) PUMP SEPTIC TANK EVERY 3-5 YRS.

INITIAL SITE SKETCH

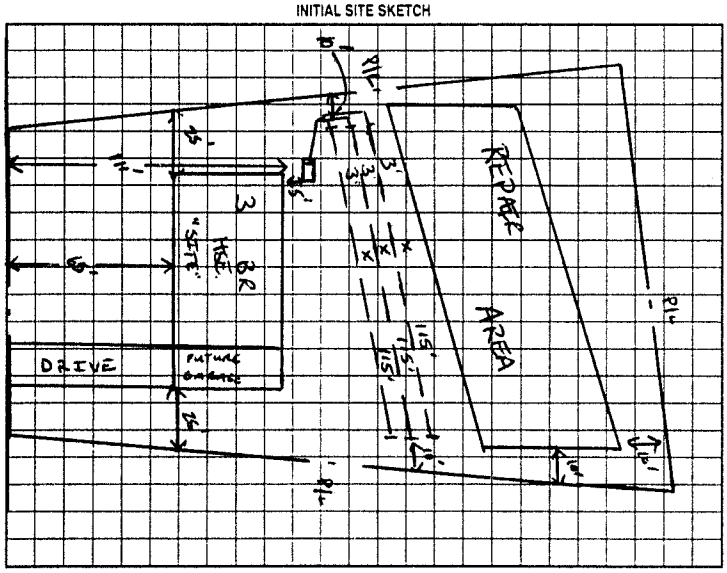

AS BUILT SKETCH

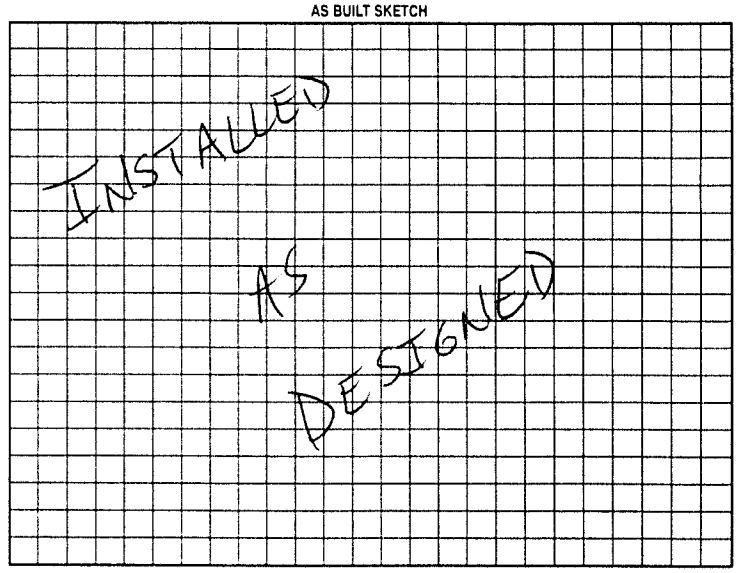

Permit can be suspended or revoked if any false information is supplied toward securing the permit/any unauthorized changes are made to the site/any unauthorized changes are made in the installation of the system. Improvement Permit with plat valid without expiration. Improvement Permit with site plan valid for sixty months. Authorization to Construct is valid for a period equal to that of Improvement Permit - not to exceed sixty months.

Signed: Timmy W Baker date 4/9/01 Installed by: COTHREN BACKHOE + GRADING

Improvement Permit by: Danny Shinn date 3/26/01 Operation Permit by: Danny Shinn date 5/9/01

Authorization to Construct by: Danny Shinn date 3/26/01 Existing System Inspection by: date

HEALTH DEPT COPY WHITE OWNER COPY (FINAL) YELLOW OWNER COPY (INITIAL) PINK