IMPROVEMENT PERMIT / AUTHORIZATION TO CONSTRUCT / OPERATION PERMIT / EXISTING SYSTEM INSPECTION

PERMIT# 095239 PIN# 4723 95 7718 DATE 3/26/01

OWNER OR CONTRACTOR JENKINS AND WILLIAMS PHONE Business (704) 872-5922 Home

ADDRESS P.O. BOX 5777, STATESVILLE, NC 28687

LOCATION BUFFALO SHOALS RD @ AERY RD 1000' ON (L)

SUBDIVISION BLOCK / SECTION LOT LOT AREA .88 Ac SITE CLASS PS DESIGN FLOW 360 GPD L.T.A.R. .35


Septic Tank 1000 Gallons STD 1012 Date 7/11/01	✓ New System Repair System Type (1)	✓ House/Mod. Home No. Bedrooms 3
Pump Tank Gallons PT Date	System Description CONVENTIONAL	Mobile Home No. Bathrooms 2
Pump Make Model Serial No	Repair System Description CONVENTIONAL	Business No. Employees
Nitrification Field: No Fields 1 Square Feet 1028 Linear Feet 345'	Maintenance Agreement Required Yes ✓ No	Other
No Lines 3 Trench Width 3' Max Trench Bottom Depth 30" Gravel Depth 12"	Slab ✓ Crawl Space Basement w/plumbing Basement w/o plumbing	

Water Supply: ✓ Individual / Public / Community

Comments/Conditions: (1) NO CUTTING OR FILLING OVER DRAINFIELD/REPAIR AREAS (2) KEEP ALL DRAINS AWAY FROM DRAINFIELD/REPAIR AREAS (3) MAINTAIN NOTED SETBACKS (4) INSTALL DRAINFIELD UNIFORM AND ON CONTOUR

Comments/Conditions: (1) PUMP SEPTIC TANK EVERY 3-5 YRS

INITIAL SITE SKETCH

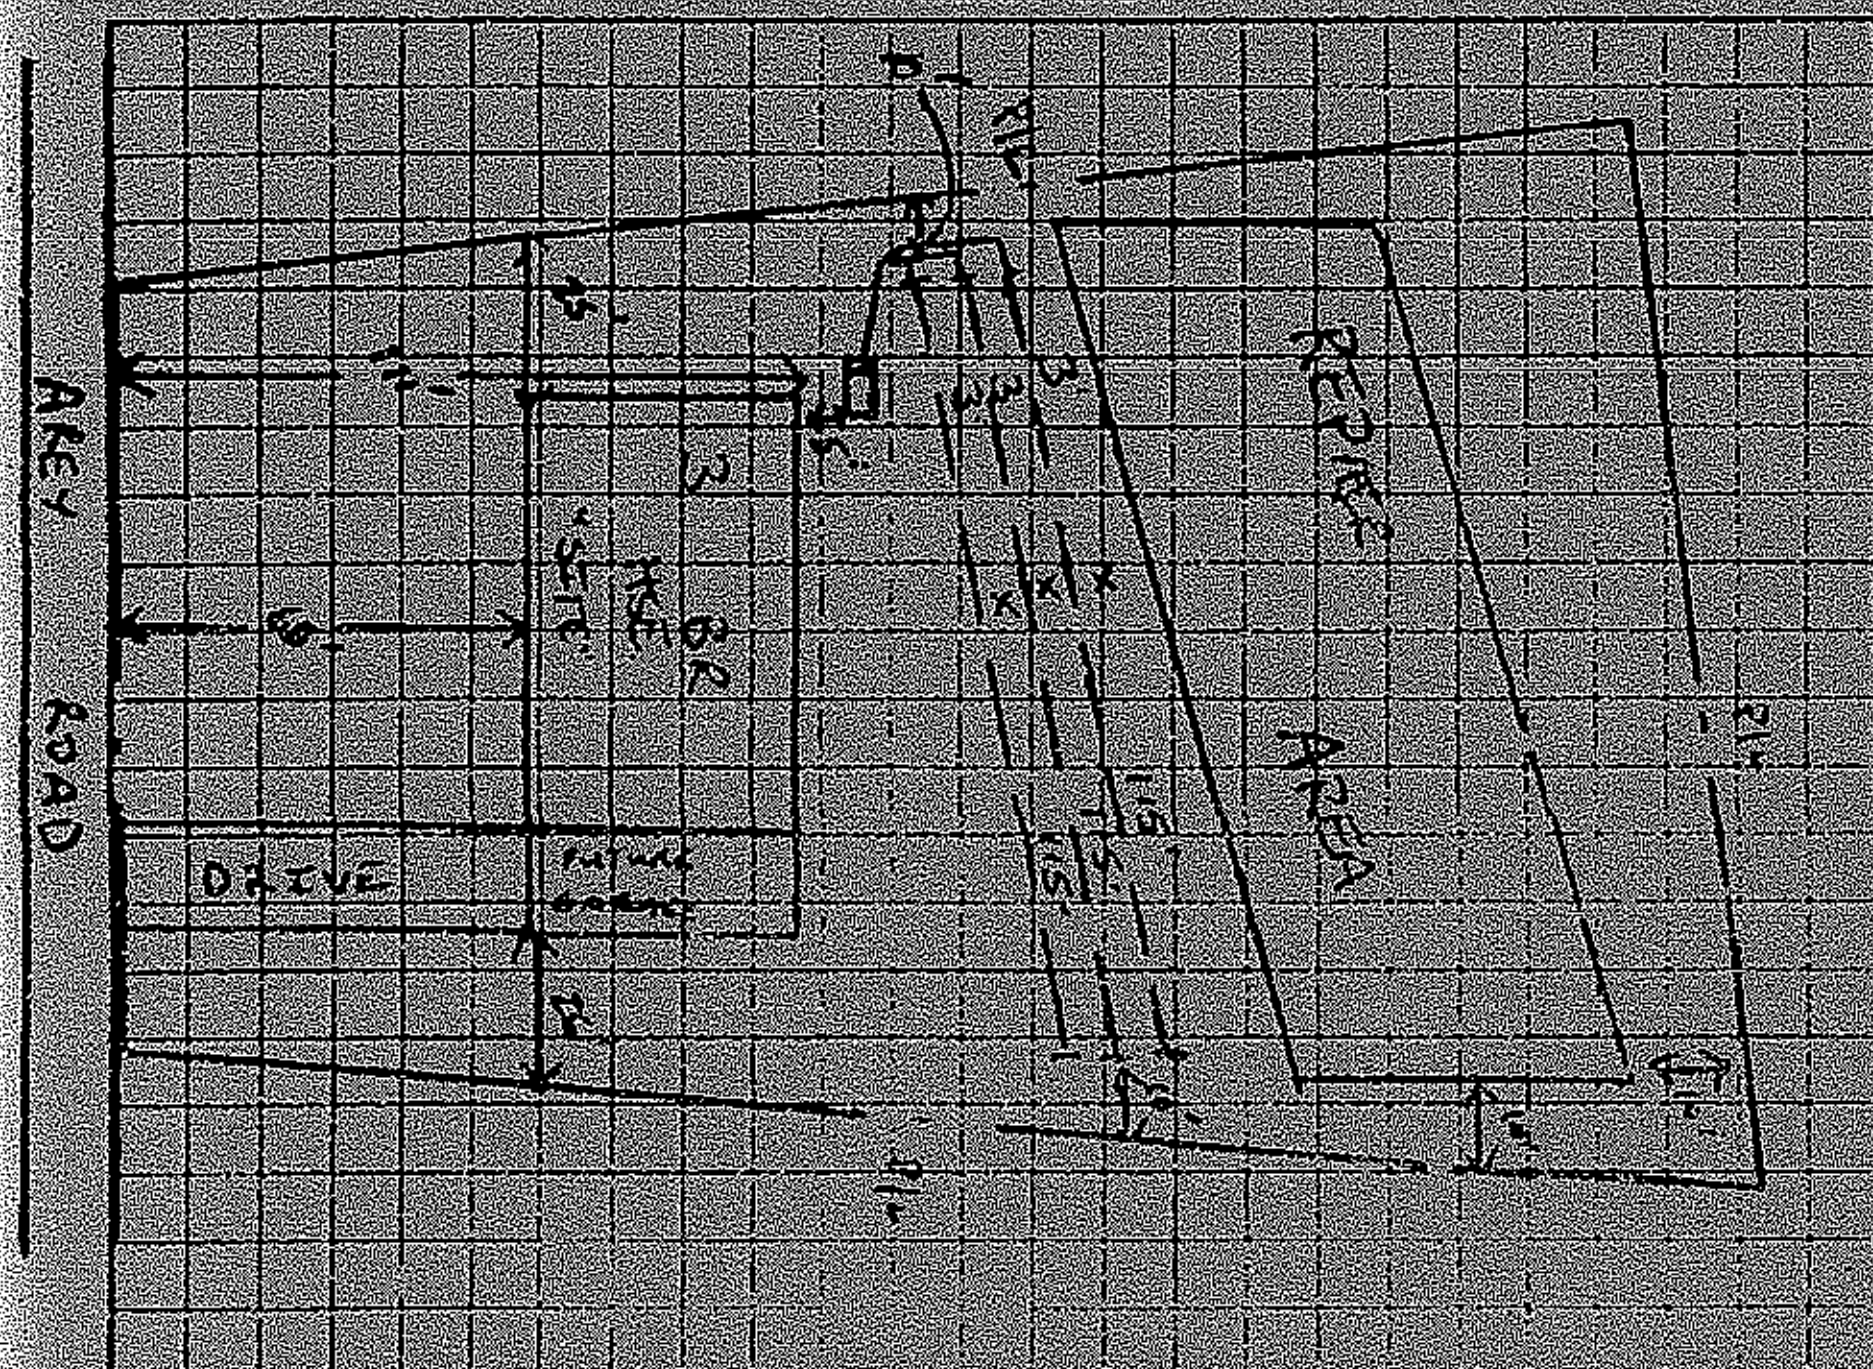

AS BUILT SKETCH

INSTALLED AS DESIGNED

The proposed Carport addition does not appear to impact the existing septic system.

**NOTE:

R.S.

Date 6-2-10

ICHD-Environmental Health Division

JAN. 14, 1989 22:56

Permit can be suspended or revoked if any false information is supplied toward securing the permit, any unauthorized changes are made to this site, any unauthorized changes are made in the installation of the system. Improvement Permit with plat valid without expiration. Improvement Permit with site plan valid for sixty months. Authorization to Construct is valid for a period equal to that of Improvement Permit - not to exceed sixty months.

Signed: Date 7/4/01 Issued by: EXTREME BACKHOE & GRADING

Improvement Permit by Date 3/26/01 Operation Permit by Date 5/9/01

Authorization to Construct by Date 3/26/01 Existing System Inspection by Date

HEALTH DEPT. COPY WHITE OWNER COPY (FINAL) YELLOW CONTRACTOR COPY PINK