6/195

IREDELL COUNTY HEALTH DEPARTMENT

STATESVILLE 704-878-5305 MOORESVILLE 704-664-5281

IMPROVEMENT PERMIT / CERTIFICATE OF COMPLETION / OPERATION PERMIT / EXISTING SYSTEM INSPECTION

PROPERTY DESCRIPTION NO. 23826 DATE 5-24-96 TAX MAP NO. 6E-15-A-10 Watershed: ☐ Yes ☑ No

OWNER OR CONTRACTOR Chris Davidson PHONE: Business _____ Home 528-6192

ADDRESS PO Box 5602 Statesville

LOCATION Buffalo Shoales Rd To Ravenwood Drive 1/4mi Rt

SUBDIVISION Ravenwood BLOCK / SECTION _____ LOT 10 LOT AREA 1 acre+ SITE CLASS. PS DESIGN FLOW 360 L.T.A.R. .13

Septic Tank: 1000 Gallons; STB 794 Date 8-9-96
Pump Tank: _____ Gallons; PT _____ Date _____
Pump Make: _____ Model _____ Serial No. _____
Nitrification Field: No Fields 1 Square Feet 900 Linear Feet 300
No Lines 3 Trench Width 36" Max Trench Bottom Depth 36" Gravel Depth N/A

☑ New System ☐ Repair System Type: I, II, III, IV, V, VI
System Description: Gravity Chambers
Repair System Description: " "
Maintenance Agreement Required: ☐ Yes ☑ No
☐ Slab ☑ Crawl Space ☐ Basement w/plumbing ☐ Basement wo/plumbing


☑ House/Mod. Home No. Bedrooms 3
☐ Mobile Home No. Bathrooms 2
☐ Business No. Employees ____
☐ Other _____

Water Supply:
☑ Individual
☐ Community
☐ Public


Comments:

Comments: 2 bedroom House Placed on System 200' Installed 9-16-96 JCM

INITIAL SITE SKETCH

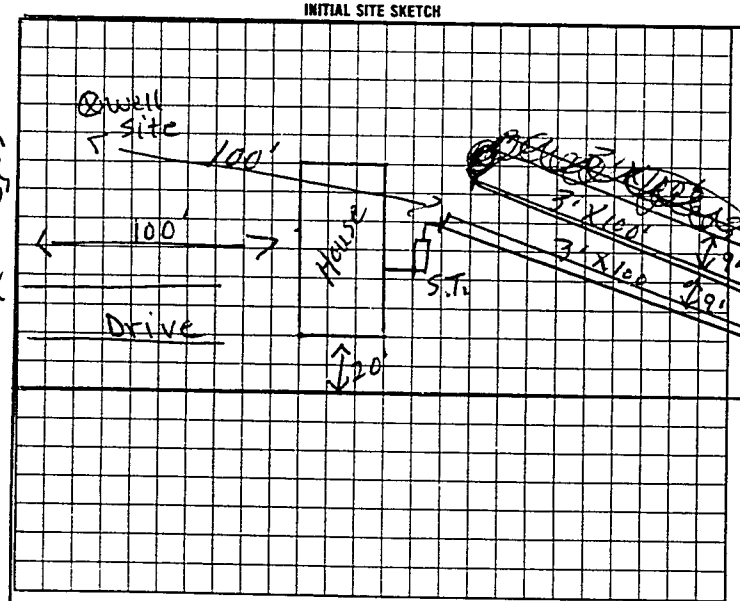

AS BUILT SKETCH

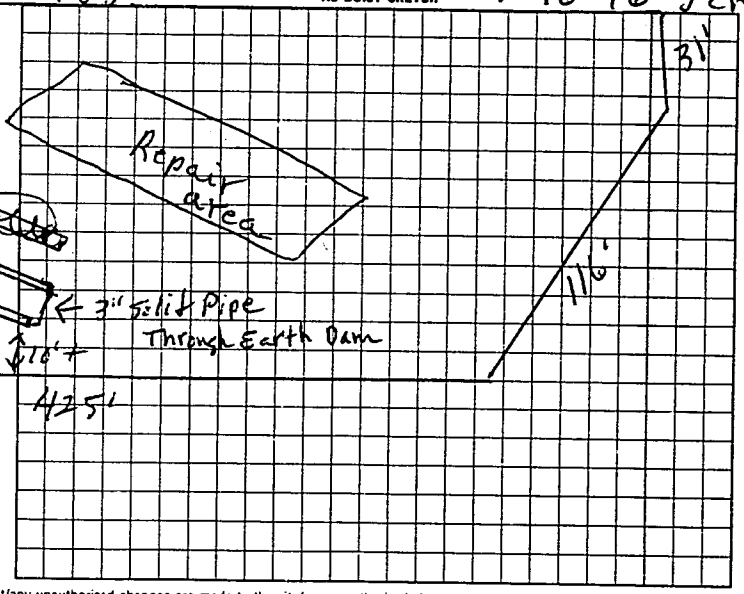

I understand that this permit can be suspended or revoked if any false information is supplied toward securing the permit/any unauthorized changes are made to the site/any unauthorized changes are made in the installation of the system.

Signed: Neal Kale

Improvement Permit by: J.C. Moore date 5-24-96

~~Existing System Inspection by:~~ Authorization to Const. J.C. Moore date 5-24-96

Installed by: Evic Swain Enterprises

Certificate of Completion by: _____ date _____

Operation Permit by: J.C. Moore date 9-16-96

HEALTH DEPT COPY WHITE | INSPECTION COPY (FINAL) GREEN | OWNER COPY (FINAL) YELLOW | INSPECTION COPY (INITIAL) PINK | OWNER COPY (INITIAL) GOLD

Authorization to Const Expired 60 mos from issue

961500