IREDELL COUNTY HEALTH DEPARTMENT

STATESVILLE 704-878-5305 MOORESVILLE 704-664-5281

#20985

IMPROVEMENT PERMIT / CERTIFICATE OF COMPLETION / OPERATION PERMIT / EXISTING SYSTEM INSPECTION

PROPERTY DESCRIPTION NO 20985 065201 DATE 1-6-97 TAX MAP NO 6E-15-A-12 Watershed: ☐ Yes ☒ No

OWNER OR CONTRACTOR Chris Davidson PHONE: Business 528-6192 Home

ADDRESS PO Box 5602 Statesville NC

LOCATION Buffalo Shoals Rd TL Ravenwood last lot on Right

SUBDIVISION Ravenwood BLOCK / SECTION LOT 12 LOT AREA 440 X 140 SITE CLASS P/S DESIGN FLOW 360 L.T.A.R. 0.3

Septic Tank: 1000 Gallons; STB 1007 Date 4-15-97

Pump Tank: Gallons; PT Date

Pump Make: Model Serial No.

Nitrification Field: No Fields 1 Square Feet 900 Linear Feet 300

No Lines 3 Trench Width 36in Max Trench Bottom Depth 36in

☒ New System ☐ Repair System Type: I, II, III, IV, V, VI

System Description: Gravity Chambers

Repair System Description: Gravity Chambers

Maintenance Agreement Required: ☐ Yes ☒ No

Gravel Depth

☒ House/Mod. Home ☐ Mobile Home ☐ Business ☐ Other

No. Bedrooms 3 No. Bathrooms 2 No. Employees


☐ Slab ☒ Crawl Space ☐ Basement w/plumbing ☐ Basement wo/plumbing

Water Supply: ☒ Individual ☐ Community ☐ Public


Comments: keep lines on contour, 9ft on center
Per owner to use Chambers
keep well 50ft from System.

Comments:
* lines run straight back
make sure all extra dirt
pushed over ends

INITIAL SITE SKETCH

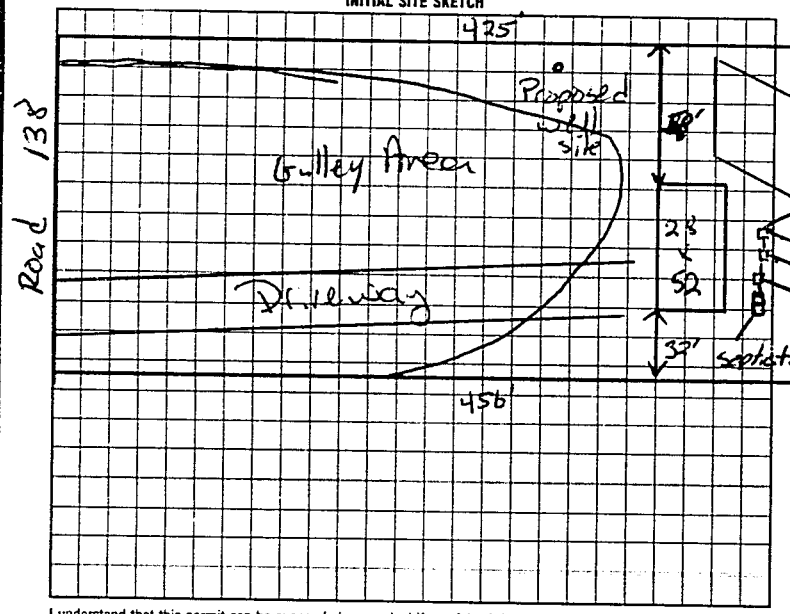

AS BUILT SKETCH

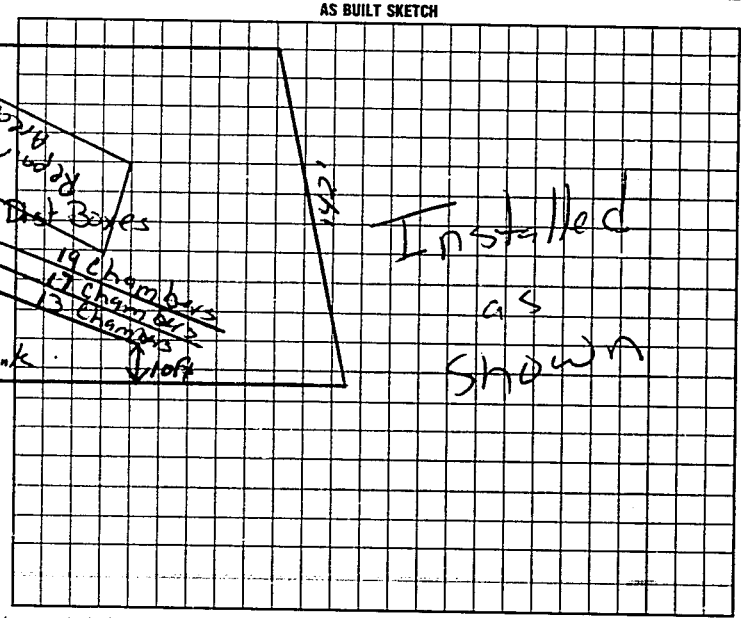

I understand that this permit can be suspended or revoked if any false information is supplied toward securing the permit/any unauthorized changes are made to the site/any unauthorized changes are made in the installation of the system. Improvement Permit is valid for 60 months from date of issuance. Authorization to const. expires 5yrs from issued date

Signed Chris Davidson

Improvement Permit by: Mark C Oates RS date 1-6-97

Existing System Inspection by Mark C Oates RS date 1-6-97

Installed by: Chris Davidson

Certificate of Completion by: date

Operation Permit by Mark C Oates RS date 5-23-97

HEALTH DEPT. COPY: WHITE INSPECTION COPY (FINAL): GREEN OWNER COPY (FINAL): YELLOW INSPECTION COPY (INITIAL): PINK OWNER COPY (INITIAL): GOLD