IREDELL COUNTY HEALTH DEPARTMENT

Statesville Phone TR 3-7271 Mooresville Phone NO 3-1271

PERMIT TO INSTALL SEPTIC TANK

Permit NO. _____ Permit Date Sept-19 19 64

Owner W.B. Cook Address R3

Installed By C Hoke Address R7


Location of Property out Buffle shoal Rd. past Third Creek on Right on hill.

Tank	Capacity	Length of Lines	Fixtures
Block ( )	800 ( )	150' ( )	No. of Baths ($)
Precast (✓)	900 ( )	175' ( )	Dishwasher ( )
	1000 ( )	200' ( )	Garbage Grdr. ( )
	1100 ( )	225' ( )	Auto-Washer (✓)
	1200 ( )	250' ( )	Other Nursery
	Other 1500 gal	Other 645 Lineft.	

NOTIFY HEALTH DEPARTMENT AT LEAST EIGHT HOURS BEFORE TANK IS TO BE INSPECTED.

Final Inspection 9-19 1964 Approved (✓) Disapproved ( )

Remarks Very steep hillside well 100'

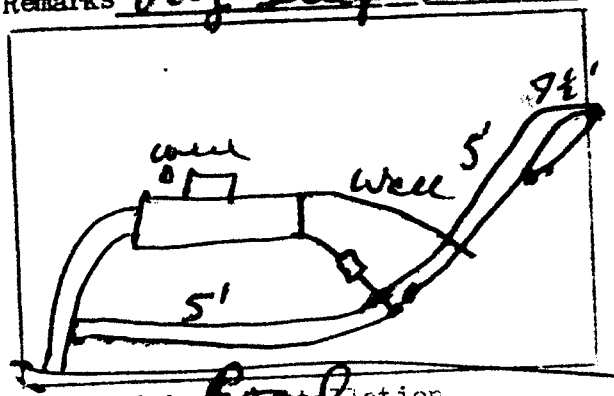

Sketch of Installation

Sanitarian