U

IREDELL COUNTY HEALTH DEPARTMENT

Statesville Phone TR 3-7271 Mooresville Phone NO 3-1271

PERMIT TO INSTALL SEPTIC TANK

Permit NO. _____ Permit Date June 25 19 68

Owner Jack Davidson Address R6 -

Installed By C Hoke Address R7


Location of Property Shiloh acres. 2nd on right.

Tank		Capacity		Length of Lines		Fixtures	
Block	( )	1000	( )	75'	( )	No. of Baths	( )
Precast	(✓)	1250	( )	250'	( )	Dishwasher	( )
		1500	( )	Other _____		Garbage Grdr.	( )
		Other _____				Other trailer	

NOTIFY HEALTH DEPARTMENT AT LEAST EIGHT HOURS BEFORE TANK IS TO BE INSPECTED.

Final Inspection _____ 19___ Approved ( ) Disapproved ( )

Remarks well 60' - wooded - tight clay - deep due to house site.

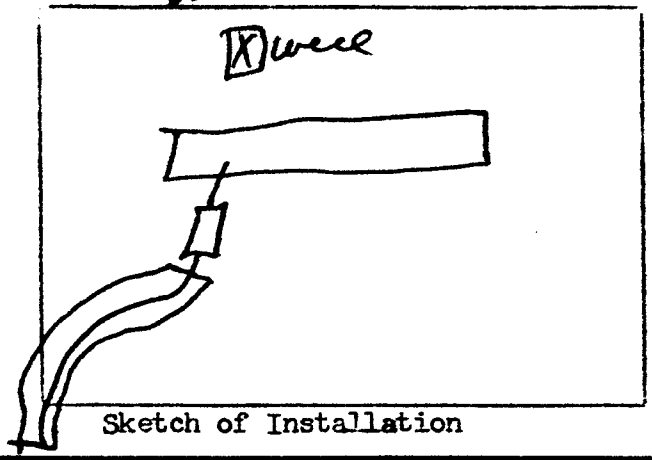

Sketch of Installation

Sanitarian