IREDELL COUNTY HEALTH DEPARTMENT

STATESVILLE 704-878-5305 MOORESVILLE 704-664-5281

IMPROVEMENT PERMIT / AUTHORIZATION TO CONSTRUCT / OPERATION PERMIT / EXISTING SYSTEM INSPECTION

PERMIT# REPAIR PIN# 4724-01-4699 DATE 9-12-02

OWNER OR CONTRACTOR DORIS B. CHURCH PHONE: Business Home 704-871-1109

ADDRESS 2602 HICKORY HWY, STATESVILLE, NC 28677

LOCATION US 70 WEST, DRIVEWAY ON RIGHT PAST ASHBROOK ROAD AT BOX #2602

SUBDIVISION BLOCK / SECTION LOT LOT AREA 1.2 ACRES SITE CLASS PS DESIGN FLOW 240 L.T.A.R. EXISTING

Septic Tank: 1000 Gallons; STB Date

Pump Tank: Gallons; PT Date

Pump Make: Model Serial No.

Nitrification Field: No Fields 1 Square Feet Linear Feet EXISTING

No Lines 1 Trench Width Max Trench Bottom Depth

☐ New System ☒ Repair System Type: I (II) III IV V VI

System Description:

Repair System Description: CONVENTIONAL, GRAVITY

Maintenance Agreement Required: ☐ Yes ☒ No

☐ Slab ☐ Crawl Space ☐ Basement w/plumbing ☐ Basement wo/plumbing

☐ House/Mod. Home No. Bedrooms 2

☒ Mobile Home No. Bathrooms 2

☐ Business No. Employees


☐ Other

Water Supply: ☐ Individual ☒ Public ☐ Community


Comments/Conditions: REPLACE EXISTING SEPTIC TANK WITH NEW TANK AT LOCATION SHOWN

Comments/Conditions: SEPTIC TANK WITH MARKER INSTALLED USING "TUFFITE" FILTER

INITIAL SITE SKETCH

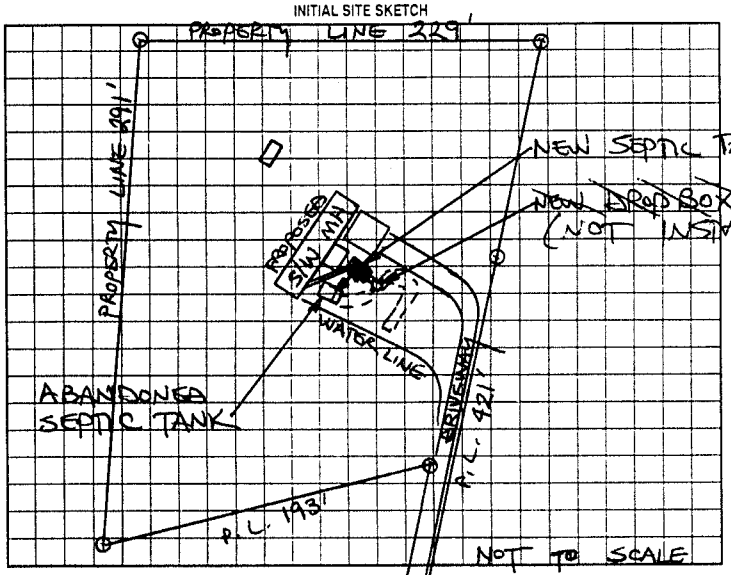

AS BUILT SKETCH

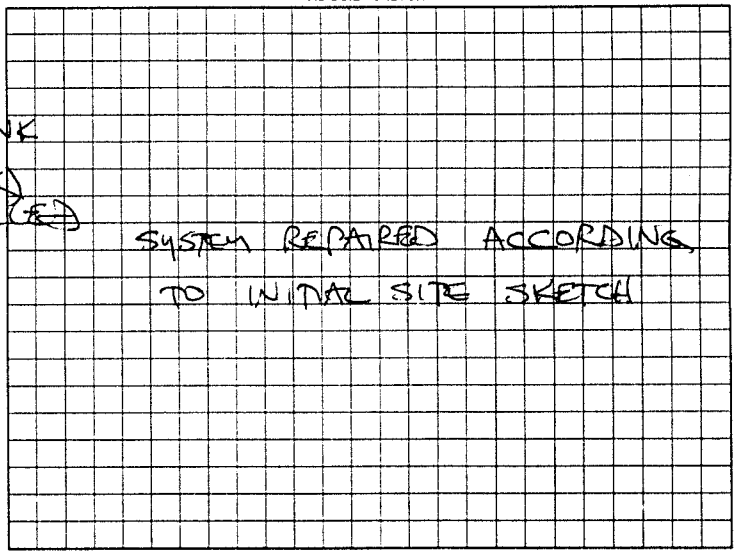

Permit can be suspended or revoked if any false information is supplied toward securing the permit/any unauthorized changes are made to the site/any unauthorized changes are made in the installation of the system. Improvement Permit with plat valid without expiration. Improvement Permit with site plan valid for sixty months. Authorization to Construct is valid for a period equal to that of Improvement Permit - not to exceed sixty months

Signed: X Doris B. Church date 9-12-02

Improvement Permit by: STEVE HEDRICK date 9-12-02

Authorization to Construct by: STEVE HEDRICK date 9-12-02

Installed by: PIEDMONT BACKHOE

Operation Permit by: STEVE HEDRICK date 9-13-02

Existing System Inspection by: date

HEALTH DEPT COPY WHITE OWNER COPY (FINAL) YELLOW OWNER COPY (INITIAL) PINK