46382

IREDELL COUNTY HEALTH DEPARTMENT

STATESVILLE 704-878-5305 MOORESVILLE 704-664-5281

IMPROVEMENT PERMIT / CERTIFICATE OF COMPLETION / OPERATION PERMIT / EXISTING SYSTEM INSPECTION

PROPERTY DESCRIPTION NO. 15834 DATE 6-14-93 TAX MAP NO. 8K-D-5

OWNER OR CONTRACTOR Roger Gibson PHONE: Business Home 873-8532

ADDRESS

LOCATION Hwy 70W, on L just past Windberry Rd. (3rd House on L past Windberry)

SUBDIVISION NA BLOCK / SECTION LOT 7 LOT AREA 11 acres SITE CLASS. P.S. L.T.A.R. .4 gpd/Ft²

Water Supply: ☑ Individual ☐ Community ☐ Public Well

Septic Tank: Existing Gallons: STB — Date —

Pump Tank: — Gallons: PT — Date —

Nitrification Field: No Fields 2 Square Feet 375 Linear Feet 125'

No Lines 1 Trench Width 36" Trench Depth 36" Gravel Depth 12"

☐ New System ☑ Repair System Type: I (II) II, IV, V, VI

System Description: Conventional, gravity

Repair System Description:

Maintenance Agreement Required: ☐ Yes ☑ No

☑ House/Mod. Home No. Bedrooms 4 Garbage Disposal: ☐ Yes ☑ No

☐ Mobile Home No. Bathrooms 3 Auto. Dishwasher: ☑ Yes ☐ No

☐ Business No. Employees Auto. Washing Machine: ☑ Yes ☐ No


☐ Other Addition to home Other

☐ Slab ☐ Crawl Space ☑ Basement w/plumbing ☐ Basement wo/plumbing

Comments

INITIAL SITE SKETCH

AS BUILT SKETCH

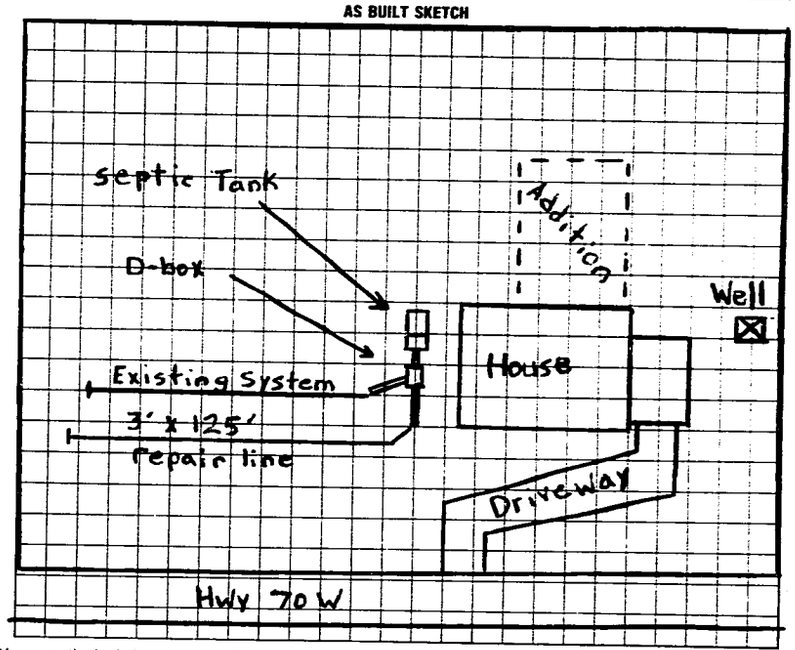

I understand that this permit can be suspended or revoked if any false information is supplied toward securing the permit/any unauthorized changes are made to the site/any unauthorized changes are made in the installation of the system. Improvement Permit is valid for 60 months from date of issuance.

Signed:

Improvement Permit by: J.C. Moore / Michael J. Dennis date 2-17-93

Existing System Inspection by: date

Installed by: A+ 1 Backhoe

Certificate of Completion by: Michael J Dennis date 6-14-93

Operation Permit by: date

HEALTH DEPT. COPY: WHITE INSPECTION COPY (FINAL): GREEN OWNER COPY (FINAL): YELLOW INSPECTION COPY (INITIAL): PINK OWNER COPY (INITIAL): GOLD