IREDELL COUNTY HEALTH DEPARTMENT

Statesville Phone TR 3-7271 Mooresville Phone NO 3-1271

PERMIT TO INSTALL SEPTIC TANK

Permit No. 238 Permit Date 4-14 1971

Owner Jimmy Wooten (Jiffy Catering) Address Statesville

Installed By Floyd Adams Address Taylorsville


Location of Property Hgwy 64 & 70 past Ashebrook Parkon right.

Tank		Capacity		Length of Lines		Fixtures	
Block	( )	~~1000~~	( )	225'	( )	No. of Baths	( )
Precast	(✓)	1250	( )	250'	( )	Dishwasher	( )
		1500	( )	Other 350'		Garbage Grdr.	( )
		Other				Other	

NOTIFY HEALTH DEPARTMENT AT LEAST EIGHT HOURS BEFORE TANK IS TO BE INSPECTED.

Final Inspection 4-14-1971 Approved ( ) Disapproved ( )

Remarks Do not pave over. Concrete Slab poured but building not complete yet. Designed by RWJ.

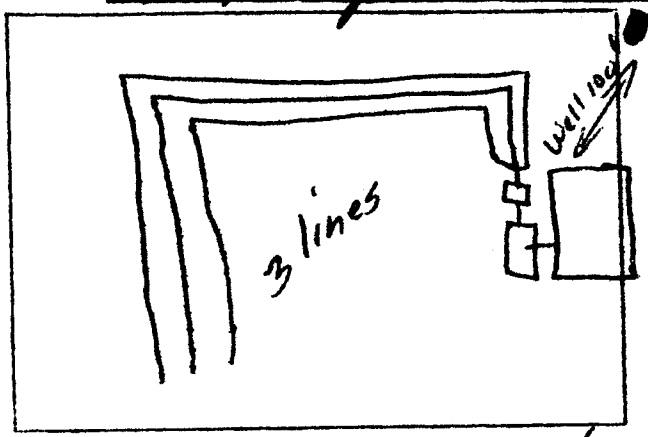

Sketch of Installation

Sanitarian