IREDELL COUNTY HEALTH DEPARTMENT

Statesville Phone TR 3-7271 Mooresville Phone NO 3-1271

PERMIT TO INSTALL SEPTIC TANK

Permit NO. _____ Permit Date May 6 1969

Owner Wooten Bros Elders Address R3 Sta.

Installed By C Hoke Edson Address K7


Location of Property Asheboro S/D #11 on isle -

Tank		Capacity		Length of Lines		Fixtures	
Block	( )	1000	( )	225'	(4)	No. of Baths	(2)
Precast	(4)	1250	( )	250'	( )	Dishwasher	( )
Lank		1500	( )	Other _____		Garbage Grdr.	( )
		Other _____				Other _____	

NOTIFY HEALTH DEPARTMENT AT LEAST EIGHT HOURS BEFORE TANK IS TO BE INSPECTED.

Final Inspection _____ 19___ Approved ( ) Disapproved ( )

Remarks Swamp land - not to good a soil condition. woodd - not liable any harm from grade or landscape work.

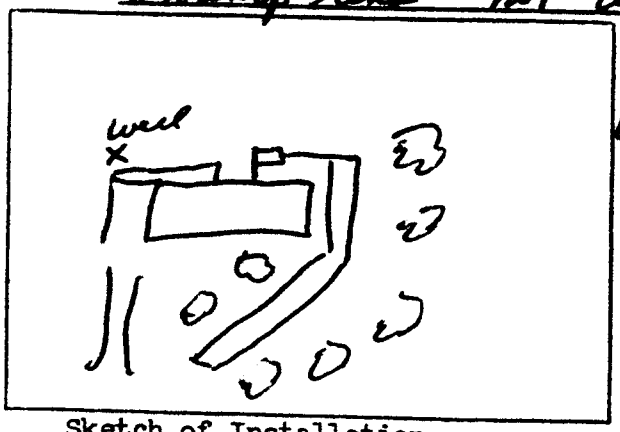

Sketch of Installation

Sanitarian