IREDELL COUNTY HEALTH DEPARTMENT

Statesville Phone TR 3-7271 Mooresville Phone No. 664-5281

PERMIT TO INSTALL SEPTIC TANK

Permit No. 204 Permit Date 2-23 1973

Owner Jim Worten Bldr (Jimmy Crider owner) Address Statesville NC

Installed By Raymond Adams Address Hiddenite N.C.

Location of Property Ashbrook Park -

House on R. on Ashbrook Drive.


Lot #50

Tank		Capacity		Length of Lines		Fixtures	
Block	( )	1000	(✓)	225'	( )	No. of Baths	(2½)
Precast	(✓)	1250	( )	250'	(✓)	Dishwasher	(✓)
		1500	( )	Other		Garbage Grdr.	( )
		Other				Other	

NOTIFY HEALTH DEPARTMENT AT LEAST EIGHT HOURS BEFORE TANK IS TO BE INSPECTED.

Final Inspection 2-23 1973 Approved (✓) Disapprcved ( )

Remarks West Iredell Water Corp

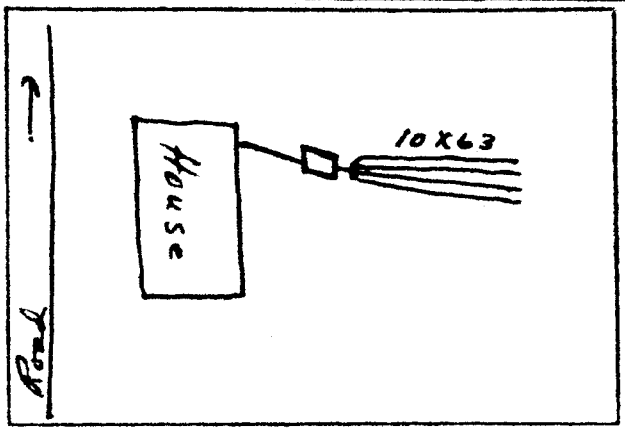

Sketch of Installation

Lines are located in a low laying area. all surface water should be diverted away from system. Builder responsible for 2 years. 30.7 tons stone used.

E. A. Stevenson

Sanitarian