1417

IREDELL COUNTY HEALTH DEPARTMENT

Statesville Phone TR 3-7271 Mooresville Phone NO 3-1271

PERMIT TO INSTALL SEPTIC TANK

Permit NO. _____ Permit Date June 28 1968

Owner Worth bros. Eldes. Address R 3

Installed By C Hoke Address R 3


Location of Property Ashbrooke S/D #9

Tank		Capacity		Length of Lines		Fixtures	
Block	( )	1000	( )	[illegible]	( )	No. of Baths	(2)
Precast	(✓)	1250	( )	250'	( )	Dishwasher	( )
		1500	( )	Other _____		Garbage Grdr.	( )
		Other _____				Other _____	

NOTIFY HEALTH DEPARTMENT AT LEAST EIGHT HOURS BEFORE TANK IS TO BE INSPECTED.

Final Inspection _____ 19__ Approved ( ) Disapproved ( )

Remarks well 50' - heavy woods. Very confined area.

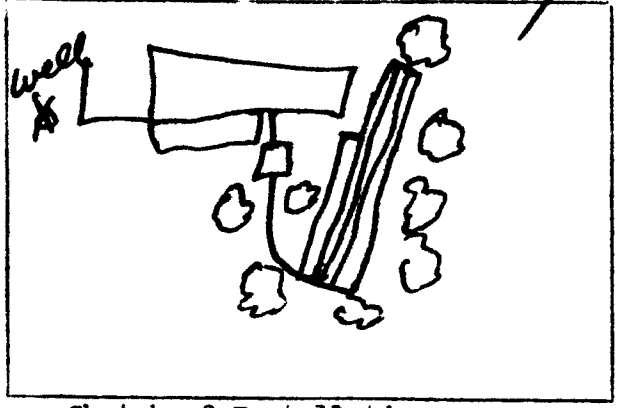

Sketch of Installation

Sanitarian