2

IREDELL COUNTY HEALTH DEPARTMENT

Statesville Phone TR 3-7271 — Mooresville Phone NO 3-1271

PERMIT TO INSTALL SEPTIC TANK

Permit NO. McCurdy 100 Permit Date June 28 1968

Owner Wooten Bros. Elders Address R 3

Installed By C Hoke Address R 7


Location of Property Oakbrooke S/D. 6-70 west. R. pool Airport rd. left at fork on left #8

Tank		Capacity		Length of Lines		Fixtures	
Block	( )	1000	( )	125'	( )	No. of Baths	(2)
Precast	(✓)	1250	( )	250'	( )	Dishwasher	( )
		1500	( )	Other		Garbage Grdr.	( )
		Other				Other	

NOTIFY HEALTH DEPARTMENT AT LEAST EIGHT HOURS BEFORE TANK IS TO BE INSPECTED.

Final Inspection ____ 19__ Approved ( ) Disapproved ( )

Remarks Owner didnot want to take out trees or undergroth. heavely wooded - confined area - well blocked any way wont to go.

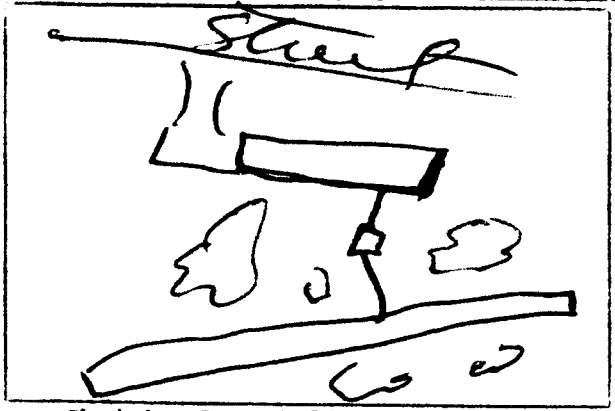

Sketch of Installation

Sanitarian