IREDELL COUNTY HEALTH DEPARTMENT

STATESVILLE 704-878-5305 MOORESVILLE 704-664-5281

IMPROVEMENT PERMIT / AUTHORIZATION TO CONSTRUCT / OPERATION PERMIT / EXISTING SYSTEM INSPECTION

PERMIT# Repair PIN#

OWNER OR CONTRACTOR Richard Faust PHONE: Business — Home (704) 872-8254 DATE 4-5-01

ADDRESS 149 Jamie Drive Statesville, N.C. 28677

LOCATION I-40 W (E) Stamey Farm Rd (L) on Ashbrook (R) on Jamie Rd on Right.

SUBDIVISION Ashbrook BLOCK / SECTION — LOT — LOT AREA 1.25 Ac SITE CLASS PS DESIGN FLOW 360 L.T.A.R. —

Septic Tank: 1000 Gallons: STB 794 Date Feb-01

Pump Tank: — Gallons: PT — Date —

Pump Make: — Model — Serial No. —

Nitrification Field: No Fields 1 Square Feet Existing Linear Feet Existing

No Lines 3 Trench Width — Max Trench Bottom Depth Existing Gravel Depth Existing

☐ New System ☒ Repair System Type: I (II) III IV V VI

System Description: Gravity Conv.

Repair System Description: —

Maintenance Agreement Required: ☐ Yes ☒ No

☒ House/Mod. Home No. Bedrooms 3

☐ Mobile Home No. Bathrooms 2

☐ Business No. Employees —

☐ Other —


☐ Slab ☐ Crawl Space ☒ Basement w/plumbing ☐ Basement wo/plumbing

Water Supply: ☐ Individual ☒ Public ☐ Community

Comments/Conditions: ① Replace old Tank w New Tank with a Sanitary Tee ② Replace distribution box if necessary ③ Move water Line away from Tank

Comments/Conditions: Installed New Septic Tank

INITIAL SITE SKETCH Not to Scale

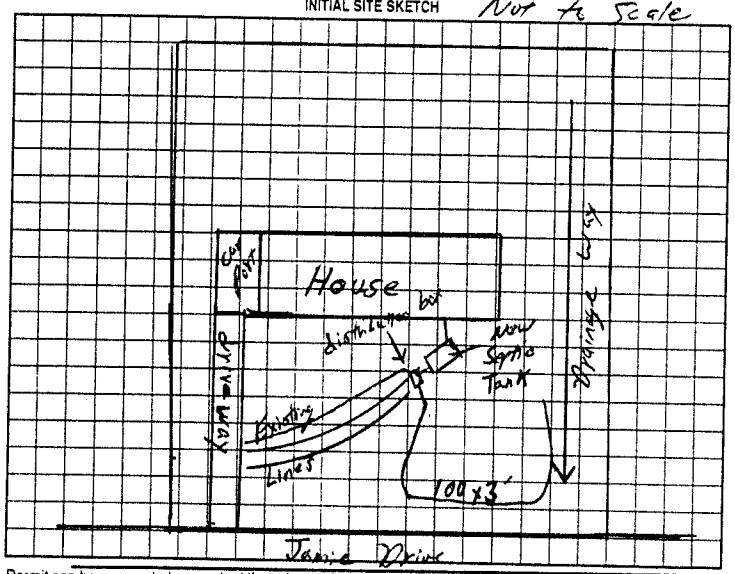

AS BUILT SKETCH

Installed New distribution box.

Installed Septic Tank Risers

Installed Label filter

as per Site Sketch

Permit can be suspended or revoked if any false information is supplied toward securing the permit/any unauthorized changes are made to the site/any unauthorized changes are made in the installation of the system. Improvement Permit with plat valid without expiration. Improvement Permit with site plan valid for sixty months. Authorization to Construct is valid for a period equal to that of Improvement Permit – not to exceed sixty months.

Signed: Richard Faust date —

Improvement Permit by: William O. Johnson RSI date 4-5-01

Authorization to Construct by: William O. Johnson RSI date 4-5-01

Installed by: Wes Lythgoe

Operation Permit by: William O. Johnson RSI date 4-12-01

Existing System Inspection by: — date —

HEALTH DEPT COPY WHITE OWNER COPY (FINAL) YELLOW OWNER COPY (INITIAL) PINK