NB

IREDELL COUNTY HEALTH DEPARTMENT

Statesville Phone TR 3-7271 Mooresville Phone NO 3-1271

PERMIT TO INSTALL SEPTIC TANK

Permit NO._____ Permit Date July 8 1966

Owner Jim Tippett Address Rt. 8 -

Installed By H. L. Hedrick Address Rt. 8 -

Location of Property Ashbrook Sub -


Old 64 + 70

Tank		Capacity		Length of Lines		Fixtures	
Block	( )	800	( )	150'	( )	No. of Baths	(2)
Precast	(✓)	900	( )	175'	( )	Dishwasher	( )
		1000	(✓)	200'	( )	Garbage Grdr.	( )
		1100	( )	225'	(✓)	Auto-Washer	( )
		1200	( )	250'	( )	Other_____	
		Other_____		Other_____			

NOTIFY HEALTH DEPARTMENT AT LEAST EIGHT HOURS BEFORE TANK IS TO BE INSPECTED.

Final Inspection July 9 1966 Approved (✓) Disapproved ( )

Remarks_____

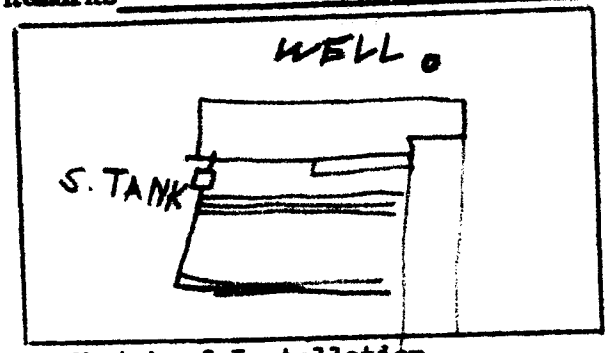

Sketch of Installation

Sanitarian