#24

IREDELL COUNTY HEALTH DEPARTMENT

Statesville Phone TR 3-7271 Mooresville Phone NO 3-1271

PERMIT TO INSTALL SEPTIC TANK

Permit NO. Wooten Bros. Elder Permit Date Sept 24 1968

Owner James Lewis "Reb" Address R6

Installed By C Hoke & Sons Address R7

Location of Property Ashebrooke S/D R at yee


on R,

Tank		Capacity		Length of Lines		Fixtures	
Block	( )	1000	(✓)	225'	( )	No. of Baths	(2½)
Precast	(✓)	1250	( )	250'	( )	Dishwasher	(✓)
		1500	( )	Other 240		Garbage Grdr.	( )
		Other				Other	

NOTIFY HEALTH DEPARTMENT AT LEAST EIGHT HOURS BEFORE TANK IS TO BE INSPECTED.

Final Inspection _____ 19___ Approved (✓) Disapproved ( )

Remarks well blocked any good lay out - wooded street not good soil for drains - deep -

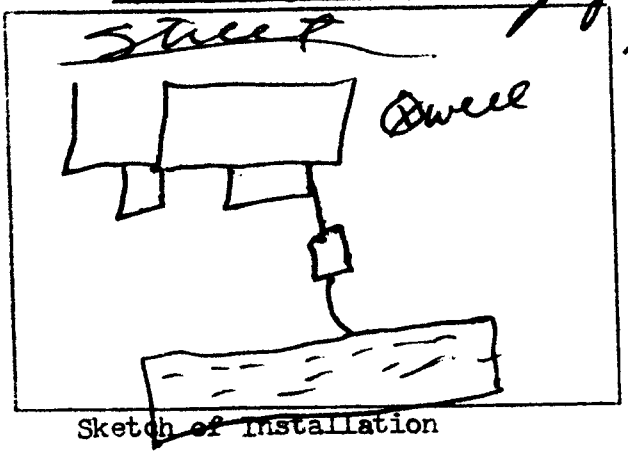

Sketch of Installation

C E Watkinson
Self appl. - R Hoke

Sanitarian