1:30

**IREDELL COUNTY HEALTH DEPARTMENT - *ENVIRONMENTAL HEALTH*** ☑ STATESVILLE OFFICE 704-878-5305 ☐ MOORESVILLE OFFICE 704-664-5281

**IMPROVEMENT PERMIT / AUTHORIZATION TO CONSTRUCT / OPERATION PERMIT / EXISTING SYSTEM INSPECTION**

PERMIT # Repair PIN # 4724029350 DATE 7-16-12

OWNER John H. Pope APPLICANT: Same PHONE: Home/Cell # 704-775-4389 Business # N/A

SITE ADDRESS 140 Jamie Dr. Statesville OWNER / APPLICANT ADDRESS 140 Jamie Dr. Statesville

SITE DIRECTIONS 70W TR on Ashbrook TR on Jamie Dr.

SUBDIVISION Ashbrook Park BLOCK / SECTION N/A LOT # 4 LOT AREA 0.51 acres DESIGN FLOW 360gpd L.T.A.R. Existing

Septic Tank Ex. Gallons: STB 760 Date 7-12-12

Pump Tank Gallons: P T Date

Pump Make Model Serial #

No. Nitrification Fields: 1 No. Lines 3 Linear Feet 375

Trench Width 36" Max. Trench Bottom Depth Ex. Gravel Depth Ex.

☐ New System ☑ Repair ☐ Expansion System Type I (II) III IV V VI

System Description: Tank Replacement

Repair System Description:

Maintenance Agreement Required ☐ YES ☑ NO

☑ GRAVITY ☐ PRESSURE

☒ Residence No. Bedrooms 3

☐ Business No. Persons

☐ Other No. Employees

☐ Slab ☐ Crawl Space

☑ Basement w/plumbing ☐ Basement w/o plumbing

**Water Supply**


☐ Private

☐ Public


☑ Community

Comments / Conditions - Pump & Crush old septic tank. Set new 1000 gal septic tank at location specified in drawing & hook to existing nitrification lines

INITIAL SITE SKETCH

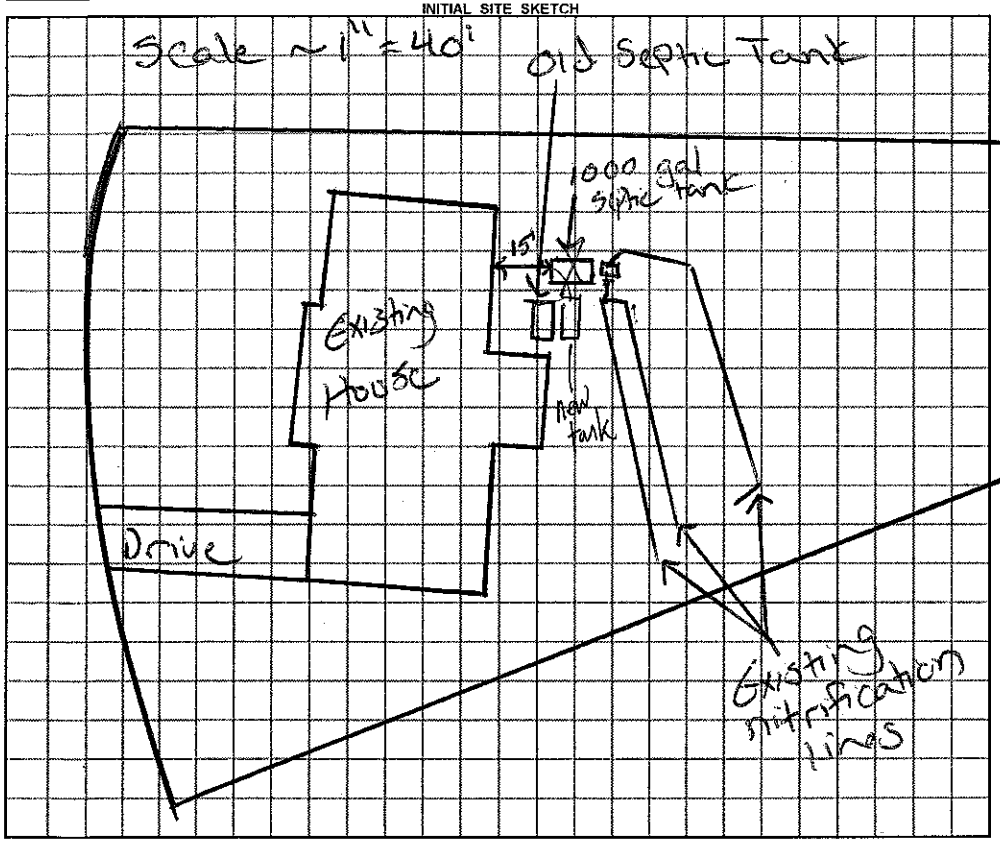


AS BUILT SKETCH

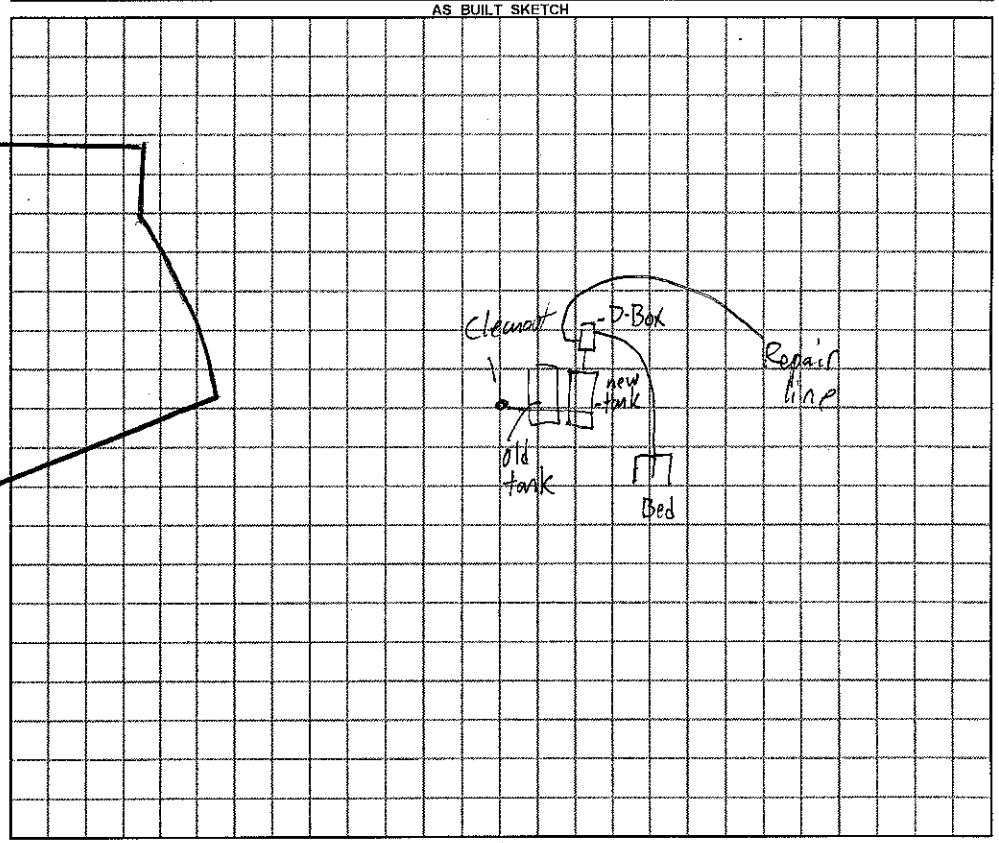


*Permit can be suspended or revoked if any false information is supplied toward securing the permit / any unauthorized changes are made to the site / any unauthorized changes are made in the installation of the system.*

☐ ***IMPROVEMENT PERMIT*** with plat valid without expiration. ☑ ***IMPROVEMENT PERMIT*** with plat valid without expiration. site plan valid 60 mo. ☑ ***AUTHORIZATION TO CONSTRUCT*** valid for period equal to IMPROVEMENT PERMIT--not to exceed 60 mo.

Owner / Applicant Signature: John H. Pope Date 7-17-12 Installed by: Jared Lentz

IMPROVEMENT PERMIT by: Justin Henderson REHS Date 7-16-12 OPERATION PERMIT by: REHS Date 8-7-12

AUTHORIZATION TO CONSTRUCT by: Justin Henderson REHS Date 7-16-12 Existing System Inspected by: REHS Date

***YOU SHOULD CONTACT A LOCATOR SERVICE PRIOR TO ANY EXCAVATION***

White Copy -- Environmental Health YELLOW COPY (Final) Owner / Applicant PINK COPY (Initial) Owner / Applicant