IREDELL COUNTY HEALTH DEPARTMENT

STATESVILLE 704-878-5305 (cw) MOORESVILLE 704-664-5281

IMPROVEMENT PERMIT / AUTHORIZATION TO CONSTRUCT / OPERATION PERMIT / EXISTING SYSTEM INSPECTION

PERMIT# 129844 PIN# 4724114739 DATE 8/31/05

OWNER OR CONTRACTOR Todd Rhyne PHONE: Business 704 902 0383 Home 704 876 2124

ADDRESS 816 WHITES FARM RD STATESVILLE, NC 28677

LOCATION 70 W (HICKORY HWY) LOT ON CORNER OF HICKORY HWY AND WINEBERRY LN

SUBDIVISION HICKORY HILLS BLOCK / SECTION ____ LOT 1 LOT AREA ____ SITE CLASS. PS DESIGN FLOW 360 GPD L.T.A.R. .3

Septic Tank: 1000 Gallons; STB 1017 Date 7-8-05
Pump Tank: 1000 Gallons; PT 17 Date 1-4-06
Pump Make: Goulds Model WE05114 Serial No. L055424
Nitrification Field: No Fields 1 Square Feet 600 Linear Feet 200
No Lines 4 Trench Width 24" Max Trench Bottom Depth 36" Gravel Depth N/A

☒ New System ☐ Repair System Type: I, II, (III), IV, V, VI
System Description: PUMP PPBPS
Repair System Description: 1948(i)-LPPPBPS/EXEMPT
Maintenance Agreement Required: ☐ Yes ☒ No

☒ House/Mod. Home No. Bedrooms 3
☐ Mobile Home No. Bathrooms ____
☐ Business No. Employees ____
☐ Other ____


☐ Slab ☒ Crawl Space ☐ Basement w/plumbing ☐ Basement wo/plumbing

Water Supply: ☐ Individual ☒ Public ☐ Community

Comments:/Conditions: INSTALL ON CONTOUR. MAINTAIN SETBACKS.
USE 4" SCH 80 MANIFOLD WITH 1/2" TAPS.
29 GPM VS 14 FT TDH
SCALE 1" = 50'

Comments:/Conditions:
Yellow Filter
no risers
ST markers

INITIAL SITE SKETCH

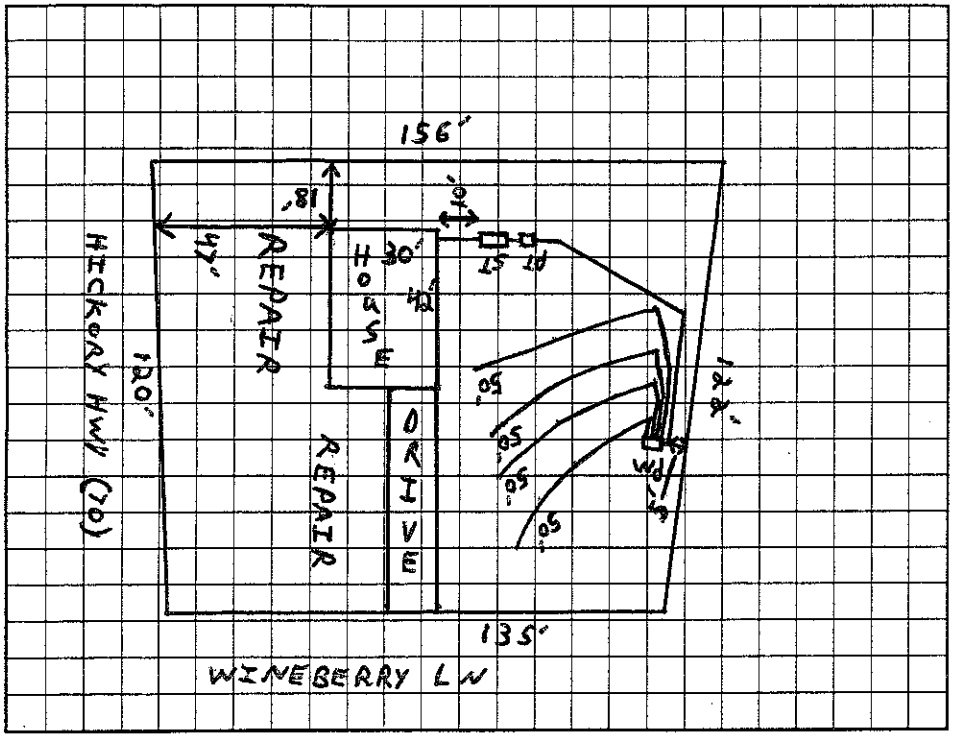

AS BUILT SKETCH

SYSTEM INSTALLED ACCORDING TO INITIAL SITE SKETCH

Permit can be suspended or revoked if any false information is supplied toward securing the permit/any unauthorized changes are made to the site/any unauthorized changes are made in the installation of the system. Improvement Permit with plat valid without expiration. Improvement Permit with site plan valid for sixty months. Authorization to Construct is valid for a period equal to that of Improvement Permit – not to exceed sixty months.

Signed: Todd Rhyne date ____

Improvement Permit by: [signature] date 8/31/05

Authorization to Construct by: [signature] date 8/31/05

Installed by: Tommy Fryo

Operation Permit by: STEVE HENDRICK date 5-31-06

Existing System Inspection by: ____ date ____

HEALTH DEPT. COPY: WHITE OWNER COPY (FINAL): YELLOW OWNER COPY (INITIAL): PINK