Owner: William Cochran

IREDELL COUNTY HEALTH DEPARTMENT

Statesville Office (704) 878-5305 Mooresville Office (704) 660-3625 PERMIT # 223112

IMPROVEMENT PERMIT / AUTHORIZATION TO CONSTRUCT / OPERATION PERMIT / EXISTING SYSTEM

PIN # 4724150285

APPLICANT: Fawn Combs APPLICANT ADDRESS: 2505 Flint Dr Statesville NC

SITE ADDRESS: 2505 Flint Dr Statesville NC PHONE: ALT. PHONE:

SITE DIRECTIONS: Bristol to Westminster TR Westover Left onto Crestridge T/R Flint Dr

SUBDIVISION: Westover SECTION: n/a LOT # 22 LOT AREA: 0.37 ac DESIGN FLOW: Ex L.T.A.R.: Ex

Septic Tank 1000 (gal) STB Date
Pump Tank (gal) PT Date
Pump Make Model Serial #
Nitrification Fields Ex # Lines Ex Linear Ft: Ex
Trench Width Ex Max. Trench Bottom Depth Ex Gravel Depth Ex


☐ New System ☑ Repair ☐ Expansion System Type: I II III IV V VI
System Description: Tank
Repair System Description:
Maintenance Agreement Required: ☐ YES ☒ NO
☒ GRAVITY ☐ PRESSURE

☒ Residence ☐ Business ☐ Other ☐ Slab ☐ Basement w/plumbing
No. Bedrooms Ex
No. Persons Ex
No. Employees
☒ Crawl Space
☐ Basement w/o plumbing

Water Supply: ☑ Private ☒ Public ☐ Community

Comments / Conditions: Pump, crush & fill existing tank maintain 50' off well and 5' off foundation

INITIAL SITE SKETCH

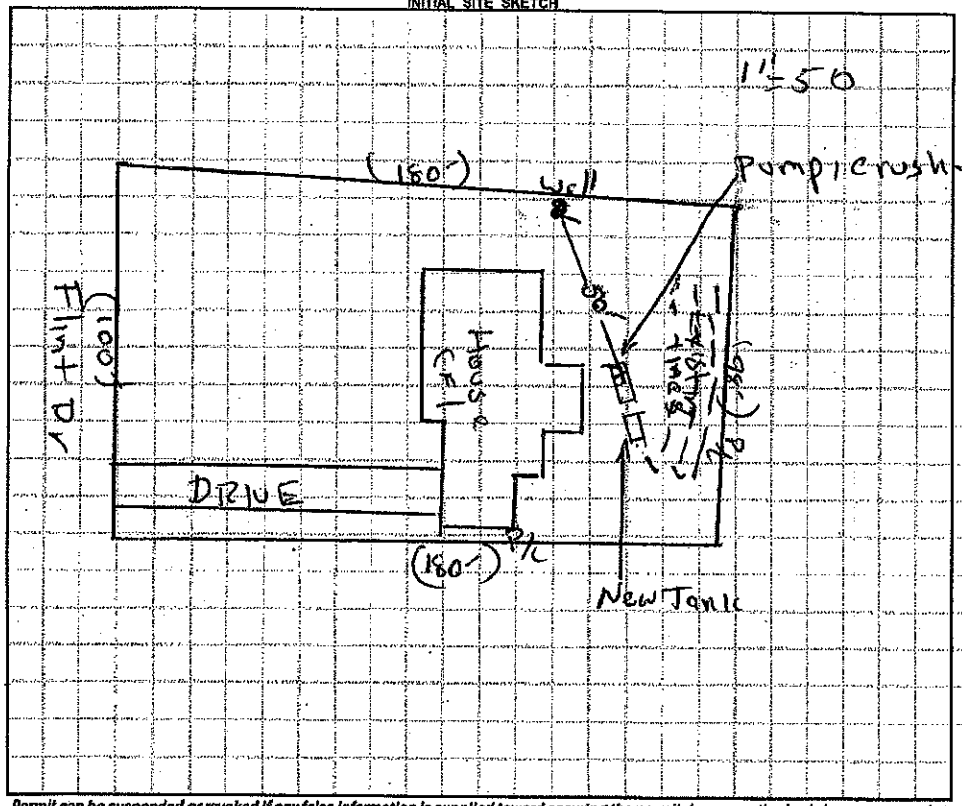

AS BUILT SKETCH

Permit can be suspended or revoked if any false information is supplied toward securing the permit / any unauthorized changes are made to the site / any unauthorized changes are made in the installation of the system. CONTACT A LOCATOR SERVICE PRIOR TO ANY EXCAVATION

☐ IMPROVEMENT PERMIT with plat valid without expiration. ☐ IMPROVEMENT PERMIT with site plan valid for 60 mos. ☐ AUTHORIZATION TO CONSTRUCT valid for period equal to IMPROVEMENT PERMIT--not to exceed 60 mo.

Owner / Applicant Signature: Fawn Combs Date: 11/17/16 Installed by: Kevin Bowles

IMPROVEMENT PERMIT by: Date: 11/17/16 OPERATION PERMIT by: Date: 11/28/16

AUTHORIZATION TO CONSTRUCT by: Date: 11/17/16 Existing System Inspected by: Date:

Health Dept. Copy - WHITE Applicant (Final Approval) - YELLOW Applicant (Conditional Approval) - PINK