IREDELL COUNTY HEALTH DEPARTMENT


ENVIRONMENTAL HEALTH DIVISION

PAGE 2: *SITE PLAN WORKSHEET*

SEE THE "SAMPLE SITE PLAN" BELOW. *INCOMPLETE SITE PLANS WILL BE RETURNED TO YOU FOR COMPLETION AND MAY RESULT IN A DELAY IN THE ISSUANCE OF YOUR SEPTIC SYSTEM PERMIT!!!*

Place an (X) beside each item as you complete the site plan:

( ) Property Line measurements are clearly identified
( ) All proposed structures are indicated
( ) Front and side setbacks from property line
( ) Preferred driveway location and well location
( ) Area you prefer your septic system to be placed
( ) North arrow, or other sufficient indicator of direction

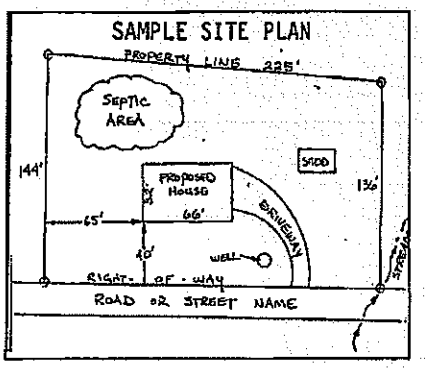

Circle N/A on the following if appropriate:

Location of septic systems and wells within 100' of your property	N/A
Location of easements and rights of ways on your property	N/A
Location of any designated wetlands on the property	N/A

USE THIS SPACE TO DRAW YOUR SITE PLAN

Show: proposed house or business footprint, wells, water lines, patios, pools and decks, and any other item that will occupy space on the site

See attached

Signature: Dawn Combs

Property owner or owner's legal representative signature (SIGNATURE REQUIRED)

11-14-16

DATE

IREDELL COUNTY HEALTH DEPARTMENT

(SEPTIC TANK) IMPROVEMENTS PERMIT AND CERTIFICATE OF COMPLETION

(Ground Absorption Sewage Disposal System -- G. S. Chapter 130-Article 13C)

OWNER OR CONTRACTOR JAMES SLOAN DATE 1-12-84 PERMIT NO.

PHONE: Business Home


LOCATION 64-70 west, T.R. on Westinghouse Dr. Drive, then T.L. into Westbrook Dev. at 1st entrance - go to bottom of hill + around curve - house on left S. R. No.

SUBDIVISION NAME WESTOVER LOT NO. 22 SECTION OR BLOCK NO.

House (✓) Mobile Home ( ) Business ( ) Other

No. Bedrooms 3 No. Bathrooms 1.0

Garbage Disposal Unit	Yes ( )	No (✓)	Character & Porosity of Soil Pgrav Suitable
Auto. Dishwasher	Yes (✓)	No ( )	Percolation Rate 2 gal/sq. ft.
Auto. Wash. Machine	Yes (✓)	No ( )	Topography 2-6%
Site Suitable	Yes (✓)	No ( )	Depth to Water Table 104
Lot Area Ample			Rock or other impervious formations none observed.

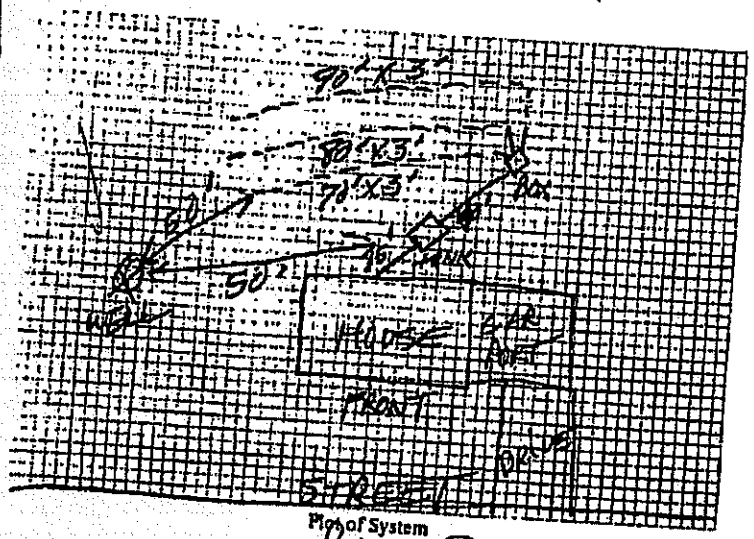

Plan of System

Size of Tank 1000 Gals.

Nitrification Field:
No. of Lines 3
Sq. Ft. 720 Linear Ft. 240
Depth of Stone in Lines 12"

Water Supply: Individual ( )
Public (✓)

Installed by Tommy Cantrell

I understand and agree to install septic tank system as specified on this Improvements Permit.

Signed:

IMPROVEMENTS PERMIT BY Steve Brown

COMMENTS:

CERTIFICATE OF COMPLETION BY
EXISTING SYSTEM CHECKED BY: Steve Brown DATE 1-12-84
DATE

CONSTRUCTION MUST COMPLY WITH ALL OTHER APPLICABLE STATE AND LOCAL REGULATIONS.
Permit is VOID if any unauthorized changes are made in installation of system and/or if any false information is supplied in making Improvements Permit.

Health Dept. Copy: White Inspection Dept. Copy: Yellow Sanitarian's Copy: Pink Owner's Copy: Gold