CW

ICHD - ENVIRONMENTAL HEALTH DIVISION

Statesville Office (704) 878-5305 Mooresville Office (704) 660-3625 PERMIT # **AP** 2022-12296

SEPTIC: IMPROVEMENT PERMIT / AUTHORIZATION TO CONSTRUCT / OPERATION PERMIT / EXISTING SYSTEM

PIN # 4724 -15 -2441

APPLICANT/OWNER: Lentz Wastewater Management APPLICANT ADDRESS: 463 Lentz Rd, Statesville, NC 28625

SITE ADDRESS: 3602 Flint Dr, Statesville, NC 28677 PHONE: (480)824-3278 ALT. PHONE –

SITE DIRECTIONS: ① Newton Dr, ② Westminister, ③ Westover, ④ Flint SAP CONTROLLED: ☐ YES ☐ ~~NO~~


SUBDIVISION: Westover SECTION: – LOT # 79 LOT AREA: – DESIGN FLOW: 360 L.T.A.R.: Ext

Septic Tank	1000	(gal)	STB	760	Date	11-20-22	☐ New System	☑ Repair	☐ Expansion	System Type: I II III IV V VI	☑ Residence	No. Bedrooms	3
Pump Tank		(gal)	PT		Date		System Description:	Existing			☐ Business	No. Persons	6
Pump Make			Model		Serial #		Repair System Description:	Tank Replacement			☐ Other	No. Employees	
# Nitrification Fields	Ext		# Lines	Ext	Linear Ft	Ext	Maintenance Agreement Required:	☐ YES	☑ NO		☐ Slab	☐ Crawl Space	
Trench Width	Ext		Trench Bottom Depth(Low side)		Ext	Gravel Depth	Ext	☑ GRAVITY	☐ PRESSURE		☑ Basement w/plumbing	☐ Basement w/o plumbing	

Water Supply: ☐ Private ☑ Public ☐ Community

Comments / Conditions: Pump, crush, fill old tank. Place new tank beside old tank.

INITIAL SITE SKETCH

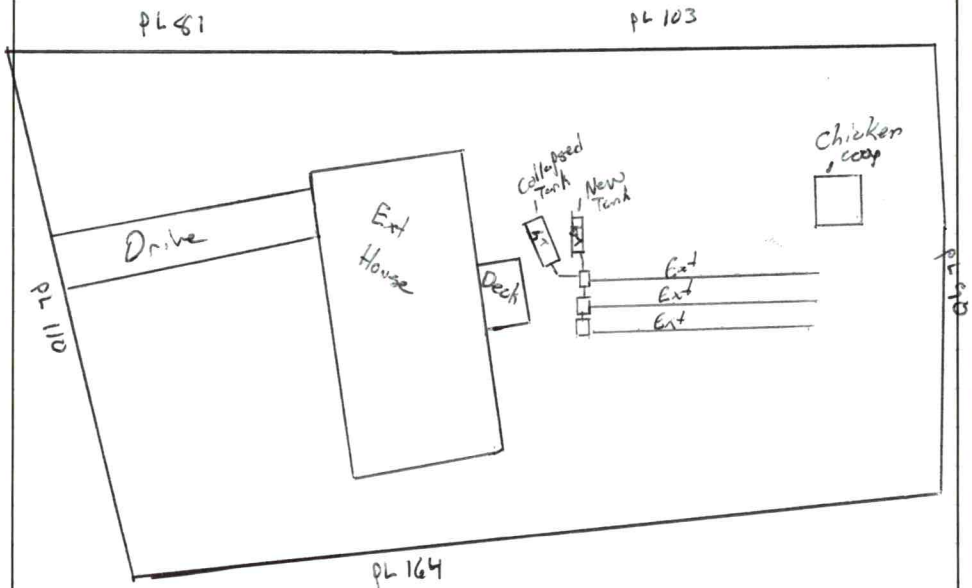

AS BUILT SKETCH

FOR SEPTIC FINAL INSPECTION CALL: 704-664-3703 between 8am-9am
the day the inspection is needed. Be sure to speak with an inspector to confirm your time.

Permit can be suspended or revoked if any false information is supplied toward securing the permit / any unauthorized changes are made to the site / any unauthorized changes are made in the installation of the system. **CONTACT A LOCATOR SERVICE PRIOR TO ANY EXCAVATION**

☐ **IMPROVEMENT PERMIT** ***with plat*** *valid without expiration.* ☑ **IMPROVEMENT PERMIT** ***with site plan*** *valid for 60 mos.* ☑ **AUTHORIZATION TO CONSTRUCT** *valid for period equal to IMPROVEMENT PERMIT--not to exceed 60 mo.*

Owner / Applicant Signature: Online Signature Date: Installed by: Lentz Wastewater

IMPROVEMENT PERMIT by: Matt Wilson Date: 1/3/23 OPERATION PERMIT by: Matt Wilson Date: 1/12/22

AUTHORIZATION TO CONSTRUCT by: Matt Wilson Date: 1/3/23 Existing System Inspected by: Date:

FOR SEPTIC FINAL INSPECTION: CALL 704-664-3703 between 8am-9am the day the inspection is needed.

Item	Date	Initials
Drain Lines Checked		
Tanks Checked		
Pressure Manifold or Valve Box Checked		
Pressure Head Set		
Electrical Checked		
Floats Set		
Alarm Checked		
Maintenance Contract Needed? Y / N		
Comments:		

Repairs Only	
	State Code
Failing System Code	
Type of Distribution	G or P
Type of Failure/Malfunction	
Primary Cause of Failure/Malfunction	
Age of System? _____	
Initial or Repair? _____	


CONNECTGIS WEB HOSTING

North Carolina Iredell County

Iredell
Printed December 30, 2022
See Below for Disclaimer



The maps prepared for this website are generated from recorded deeds, plats, and other public records. Users of these maps are hereby notified that the information provided herein should be verified. Iredell County assumes no legal responsibilities for any of the information contained on this site. Users are advised that the use of any of this information is at their own risk. All maps on this site were prepared using a 1000â€™ Grid based upon the North Carolina State Plane Coordinate System from the 1983 North American Datum. The delinquent real property tax overlay is updated monthly. The information presented is not intended to be used or relied upon as official notice of tax liens. For additional information regarding delinquent taxes, contact the Iredell County Tax Collector's Office.

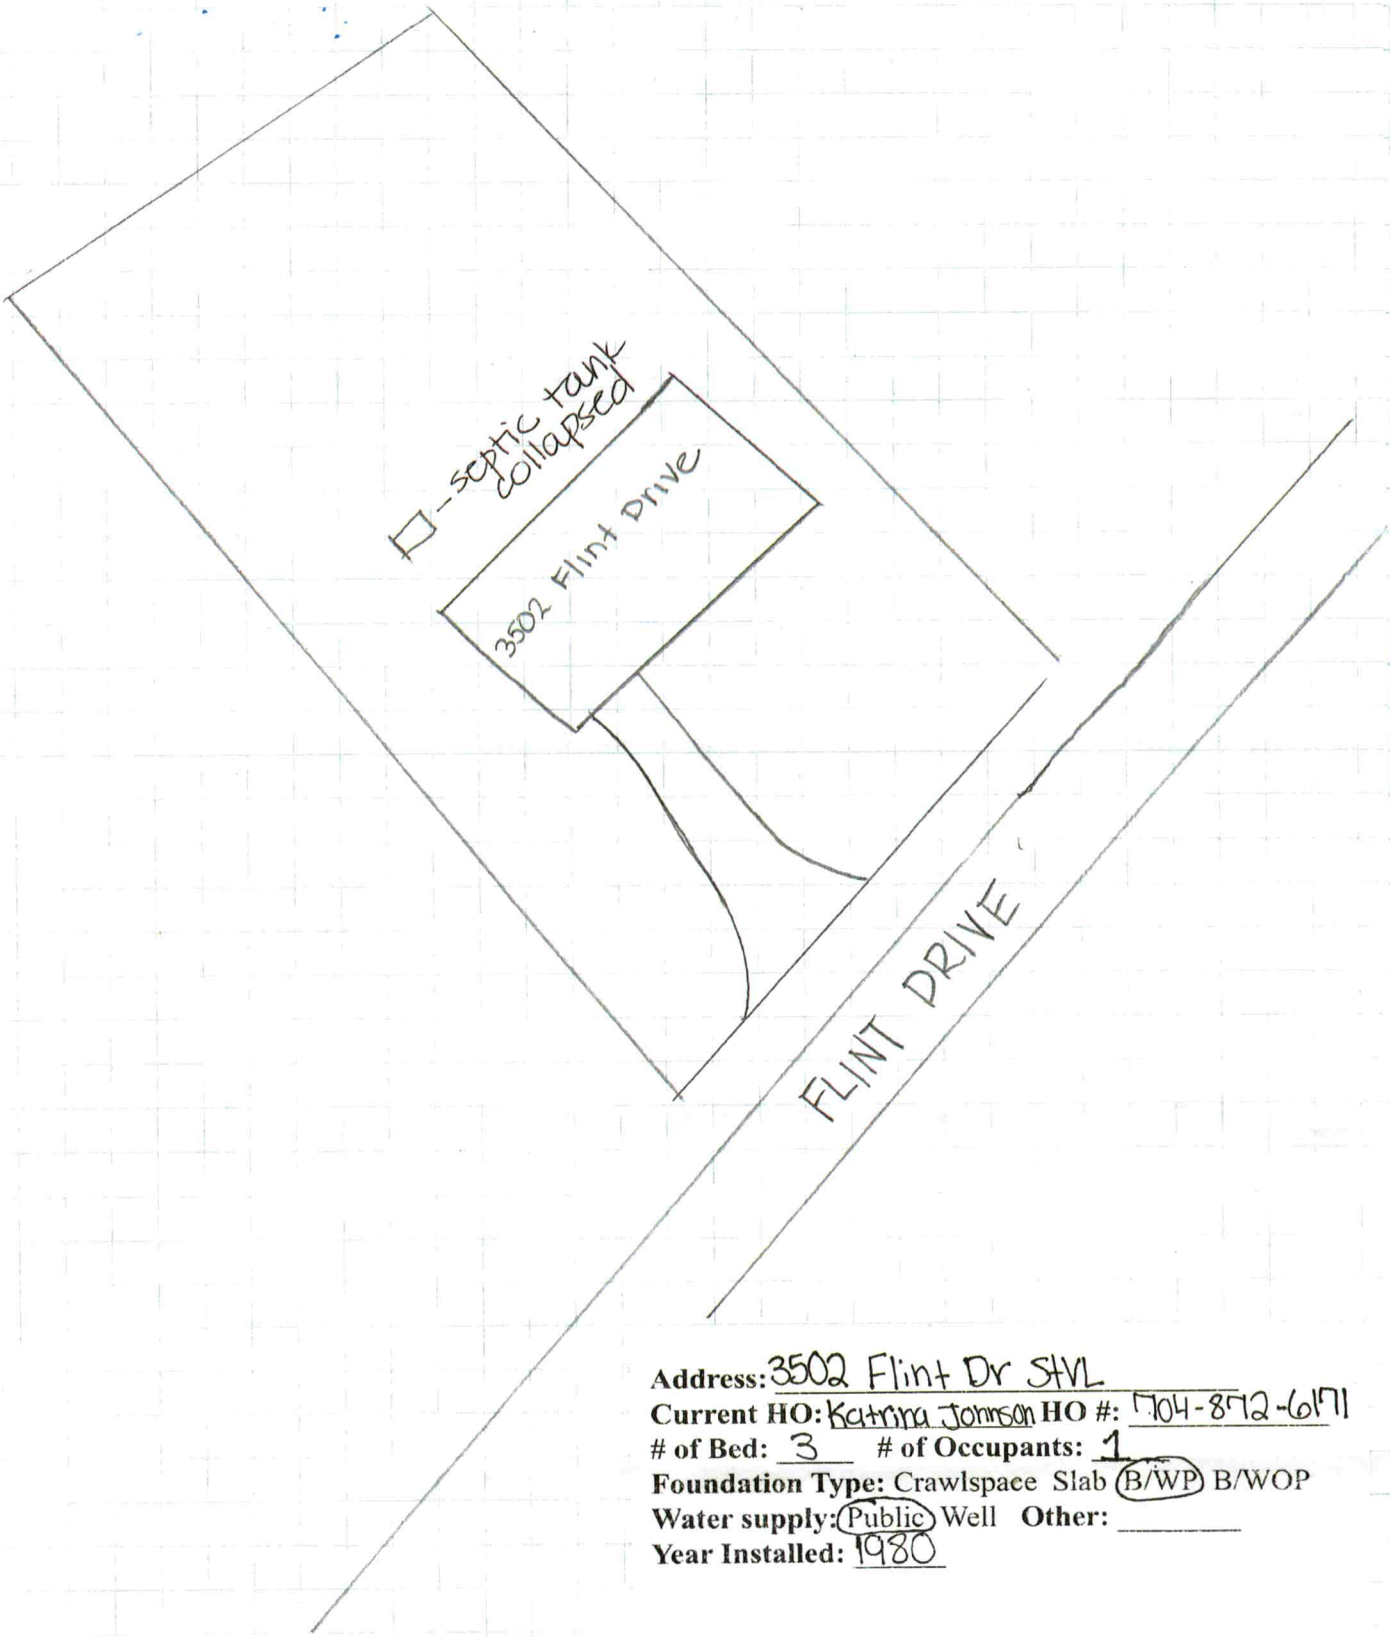

Address: 3502 Flint Dr SVL
Current HO: Katrina Johnson **HO #:** 704-872-6171
# of Bed: 3 **# of Occupants:** 1
Foundation Type: Crawlspace Slab (B/WP) B/WOP
Water supply: (Public) Well **Other:** _____
Year Installed: 1980