IREDELL COUNTY HEALTH DEPARTMENT - *ENVIRONMENTAL HEALTH* ☐ STATESVILLE OFFICE 704-878-5305 ☐ MOORESVILLE OFFICE 704-664-5281

IMPROVEMENT PERMIT / AUTHORIZATION TO CONSTRUCT / OPERATION PERMIT / EXISTING SYSTEM INSPECTION

PERMIT # Repair PIN # 4924-16-6540 DATE 23 June 11

OWNER SEVERO DIAZ APPLICANT: PHONE: Home/Cell # (704) 657-8368 Business #

SITE ADDRESS 706 Wellwood Av. Statesville OWNER / APPLICANT ADDRESS

SITE DIRECTIONS Westminster TR Westover Go to top of hill - TL Crestridge TR Westmont - TL Wellwood - on Rt.

SUBDIVISION WESTOVER BLOCK / SECTION LOT # 124 LOT AREA 0.35Ac. DESIGN FLOW 360g/d L.T.A.R. 0.3 y/ff²/d

Septic Tank Exist Gallons: STB Date

Pump Tank Gallons: P T Date

Pump Make Model Serial #

No. Nitrification Fields: 1 No. Lines 4 Linear Feet 300

Trench Width 36" Max. Trench Bottom Depth 36" Gravel Depth NA

☐ New System ☑ Repair ☐ Expansion System Type I II (III) IV V VI

System Description:

Repair System Description: 25% Reduction System

Maintenance Agreement Required ☐ YES ☑ NO

☑ GRAVITY ☐ PRESSURE

☑ Residence No. Bedrooms 3

☐ Business No. Persons

☐ Other No. Employees

☐ Slab ☑ Crawl Space


☐ Basement w/plumbing ☐ Basement w/o plumbing

Water Supply
☐ Private
☑ Public
☐ Community

Comments / Conditions: Add 300' of 25% Reduction system to existing septic system.

*This system shall be repaired within 30 Days from the date of this permit.

INITIAL SITE SKETCH

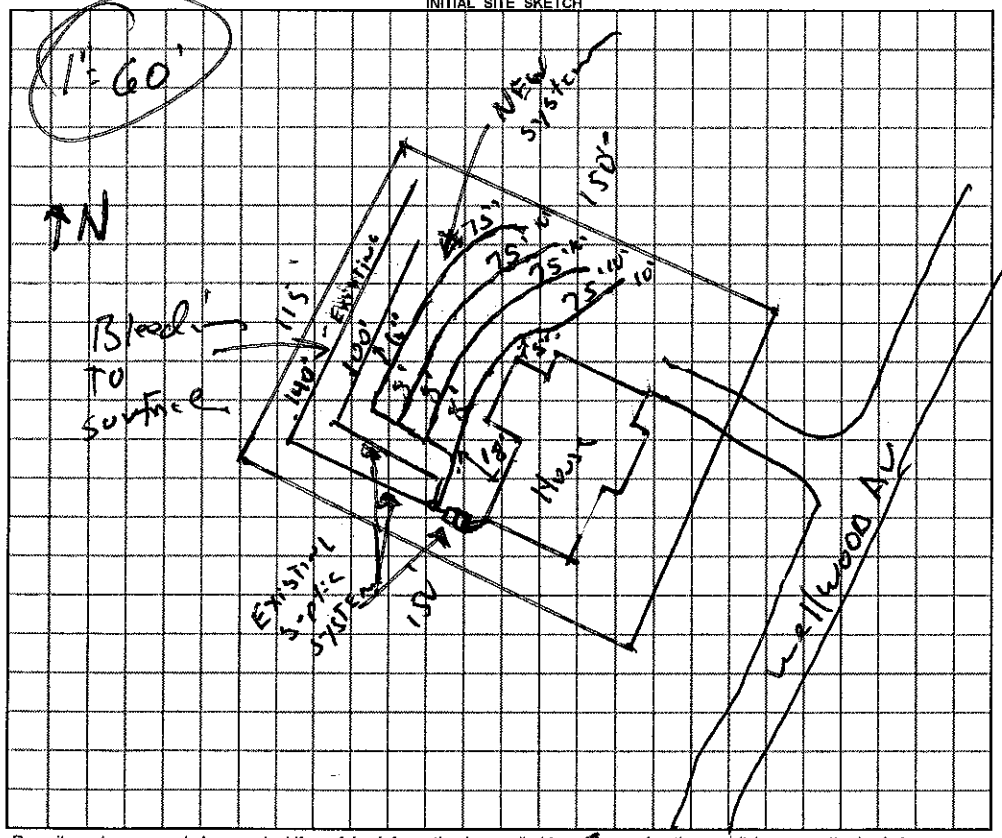

AS BUILT SKETCH

Installed as Drawn

Permit can be suspended or revoked if any false information is supplied toward securing the permit / any unauthorized changes are made to the site / any unauthorized changes are made in the installation of the system.

☐ ***IMPROVEMENT PERMIT*** with plat valid without expiration. ☑ ***IMPROVEMENT PERMIT*** with ~~plat valid without expiration.~~ site plan valid 60 mo. ☑ ***AUTHORIZATION TO CONSTRUCT*** valid for period equal to IMPROVEMENT PERMIT--not to exceed 60 mo.

Owner / Applicant Signature: Anna E. Fitz Date 10-17-11 Installed by: ADAN Garcia # 3774

IMPROVEMENT PERMIT by: [signature] REHS Date 23 June 11 OPERATION PERMIT by: [signature] REHS Date 3 November 11

AUTHORIZATION TO CONSTRUCT by: [signature] REHS Date 23 June 11 Existing System Inspected by: REHS Date

YOU SHOULD CONTACT A LOCATOR SERVICE PRIOR TO ANY EXCAVATION

White Copy -- Environmental Health YELLOW COPY (Final) Owner / Applicant PINK COPY (Initial) Owner / Applicant