IREDELL COUNTY HEALTH DEPARTMENT

STATESVILLE 704-878-5305 MOORESVILLE 704-664-5281 52747

IMPROVEMENT PERMIT / CERTIFICATE OF COMPLETION / OPERATION PERMIT / EXISTING SYSTEM INSPECTION

PROPERTY DESCRIPTION NO. City of Statesville DATE 11-23-93 TAX MAP NO. 8L-2-A-103 Watershed: ☐ Yes ☐ No

OWNER OR CONTRACTOR Hope Bros. PHONE: Business Home 872-4111

ADDRESS 1120 Barkley Rd. Statesville N.C. 28677

LOCATION I-40W Th Hwy 90 TR Bristol Dr TR Westminster TR Westover Estates Lot # 103

SUBDIVISION Westover Est. BLOCK / SECTION — LOT 103 LOT AREA 95' x 165' SITE CLASS. P.S. DESIGN FLOW 360 L.T.A.R. .35 gpd/ft²

Septic Tank: 1000 Gallons: STB 1012 Date 9-26-94

Pump Tank: — Gallons: PT — Date —

Pump Make: — Model 1050 Serial No. 350

Nitrification Field: No Fields 1 Square Feet 1035 Linear Feet 345

No Lines 5 Trench Width 36" Max Trench Bottom Depth 36" Gravel Depth 12"

☑ New System ☐ Repair System Type: I, II, III, IV, V, VI

System Description: conventional, gravity

Repair System Description: " "

Maintenance Agreement Required: ☐ Yes ☑ No

☐ Slab ☐ Crawl Space ☑ Basement w/plumbing ☐ Basement wo/plumbing

☑ House/Mod. Home No. Bedrooms 3

☐ Mobile Home No. Bathrooms 1.5

☐ Business No. Employees


☐ Other

Water Supply: ☐ Individual ☑ Community ☐ Public


Comments: Keep Nitrification lines on contour. Keep system 10' from all property lines, 5' from foundation of home, and 10' from water line. 100% Repair area. conventional, gravity fed.

Comments:

INITIAL SITE SKETCH

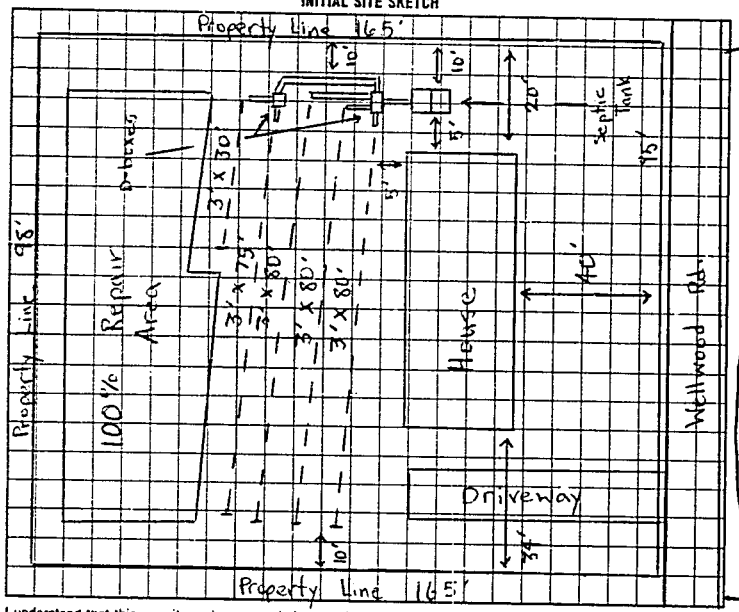

AS BUILT SKETCH

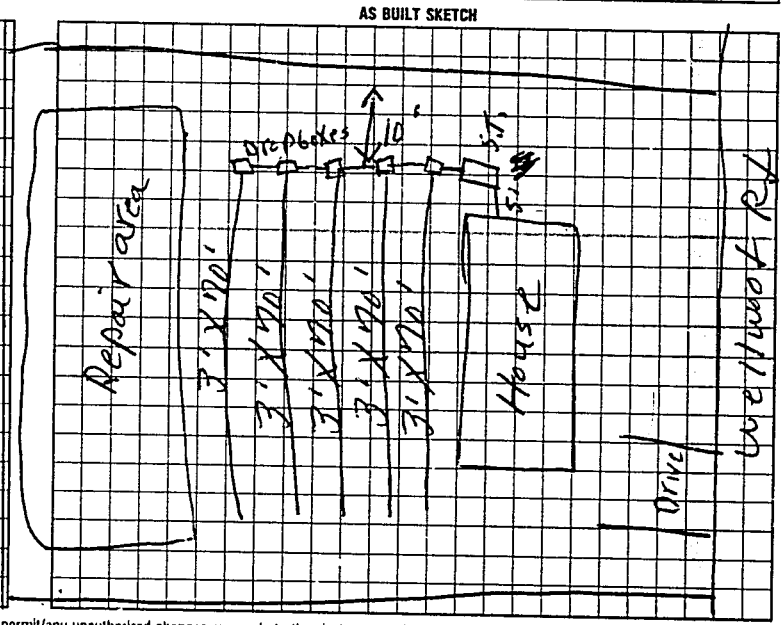

I understand that this permit can be suspended or revoked if any false information is supplied toward securing the permit/any unauthorized changes are made to the site/any unauthorized changes are made in the installation of the system. Improvement Permit is valid for 60 months from date of issuance.

Signed: [signature]

Improvement Permit by: Michael J. Denver date 11-23-93

Existing System Inspection by: date

Installed by: Arnie Duncan

Certificate of Completion by: E. C. Moore date 1-13-95

Operation Permit by: date

HEALTH DEPT. COPY. WHITE INSPECTION COPY (FINAL). GREEN OWNER COPY (FINAL). YELLOW INSPECTION COPY (INITIAL). PINK OWNER COPY (INITIAL). GOLD

827000